


Log of Baker Well #1

Drilling Contr.
Busby & Veeder

Comm. Feb. 28, 1920
Comp. Mar. 3, 1920

County 27 32 19 E
Sec. Two Rng.

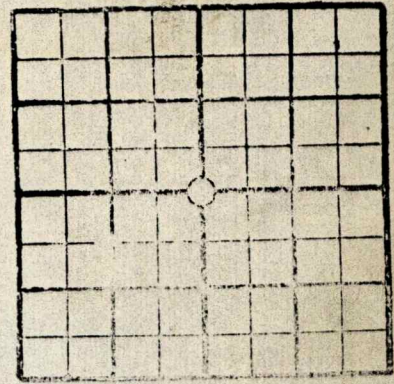

SOIL, dark soft	0	5
lime white hard	5	20
slate dark soft	20	22
lime white hard	22	36
shale light soft	36	55
sand light hard	55	80
shale light soft	10	90
sand light hard	90	125
shale dark hard	125	156
lime pink hard	156	178
shale dark soft-gas	178	188
shale light soft	188	235
lime brown hard	235	265
shale dark soft	265	271
lime light hard	271	286
shale dark hard (gas & water)	286	288
lime brown hard	288	293
shale light soft	293	297
shale dark hard	297	310
shale light soft	310	365
shale dark hard (gas)	365	371
lime light hard	371	374
shale light soft	374	392
lime dark hard (gas)	392	395
shale dark hard	395	400
lime light soft	400	402
shale light soft	402	410
shale dark hard	410	416
lime light hard	416	418
shale dark soft	418	430
lime dark hard (gas)	430	433
sandy shale light and soft (gas)	437	444
shale dark soft	444	454
shale light soft	454	458
shale dark soft	458	468
shale light soft	468	505
shale dark soft	505	510
sandy shale light hard	510	515
sand light hard (gas pay)	515	525
sand brown hard (gas pay)	525	536


83

104

133

Remarks:

Rigging up and running tower gas used 14 Days.

Casing Record

8 1/2" 41' 8" left in
6 1/2" 300' " "
2" 538'

6 1/2 Packer (Extra Dodge) set @ 480'

280

32-19