


Section 3 Township 32 Range 5E

Well No. 1 Lowe

Company Fortier & Wright

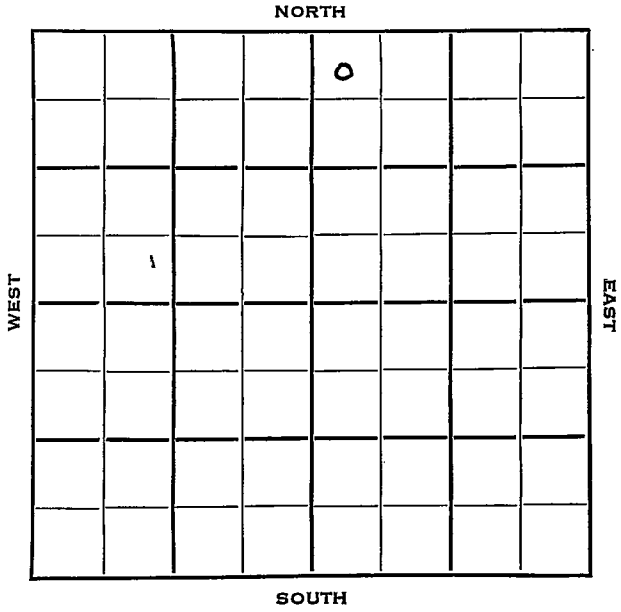

2

Cowley

KANSAS


SEC. 3	TWP. 32	R. 5E ✓
-----------	------------	------------

WELL NO. 1 Lowe FARM

COMPANY Fortier & Wright

CONTRACTOR

430 _____ Ft. from N. Line
 _____ Ft. from S. Line
 _____ Ft. from E. Line
 330 _____ Ft. from W. Line

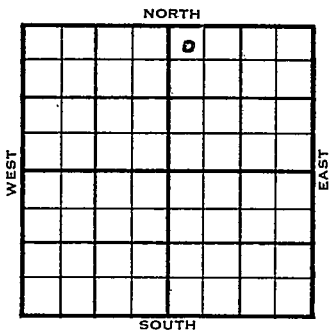

NW NW NE (TWIN)

1953	ELEVATION 1269'	REPORT
------	--------------------	--------

10/28
12/30

Location
 Spud 11-11-53
 D&A
 TD 2398'
 8" @ 114'
 Layton 2341'
 TD 2398'
 5" @ 2378'
 24/2342-52, frac 24 bopd 400 bw
 D&A

ABANDONED

