

Cowley

KANSAS

3

32S

5E


SECTION _____ TOWNSHIP _____ RANGE _____

#1 Elrod

WELL NO. _____

COMPANY Cymco Petr. Corp.

NORTH C W/2 W/2 NW

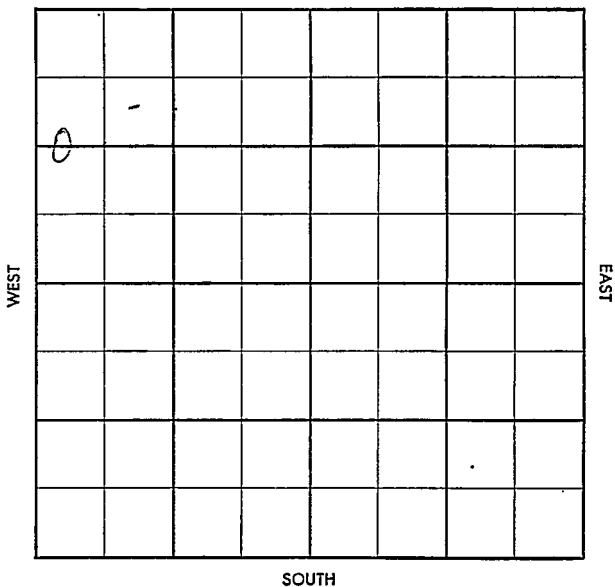

~~XXXXXXXXXX~~
~~XXXXXXXXXX~~

County Cowley Elev. _____
 Sec. 3 Twp. 32 Rge. 5E
 Company Cymco Pet. Corp.
 Farm Name Elrod No. 1

TOPS	DEPTH	LOG	DATUM
Anh.			
Tp.			
H.			
Tr.			
Dg.			
B.L.			
L.			
K.C.			
B.K.C.			
Ce.			
C.			
M.			
M.			
K.			
Mz.			
Mq.			
V.			
S.			
S.			
A.			
R.			
Pf.			
G.			
T.D.			

Loc. in Sec. _____
G W/2 W/2 NW
 Geol. _____
 Contr. Gearhart-
Canady
 Pool _____
Elrod

FIRST REPORT
 JUL 30 58

Date Comm. 7-25-58
85/8" @ 196' w/151 Drlg. 1415

Co.
 Lse.
 No.
 Sec.
 T.
 R.

Twp. Pool

Co. Facet

5-513-B

County Cowley Elev. 1303 AF 1306

Sec. 33 Twp. 32 Rge. 5E

Company Emce Pet. Corp.

Farm Name Elrod No. 1

TOPS	DEPTH	LOG	DATUM
Ann	1985		
Tr	2374		
H			
Tr			
Dg			
B.L			
L			
K.C			
B.K.C			
Ce			
C			
M			
M			
K			
Mz			
Mq			
V			
S			
S			
A			
R			
Pf			
G			
T.D	2425		

Loc. in Sec.

C 1/2 1/2 NW

Geol.

Contr. Gearhart-

Canady

Pool

Elrod

COMPLETE

SEP 24 58

Date Comm. 7-25-58

25/81 @ 196' w/151 Dring. 1415

AUG 6 58 AUG 13 58 DST 2377-97

1 1/2 hrs 180 069cm 30' 06

gross FP 15 75 BHP 570/20

4 1/2 24 29/125 AUG 20 58 AUG 27 58

OL (20) 2377-82 SF 1x1 P.L.

Sat 1500H 4hr POP

SEP 10 58 SEP 17 58 SEP 24 58

P. 25 BOLD Tr. Wk.