


Section 36 Township 32 Range 4 E

Well No. # 1 Kittelson

Company T. K. & E.

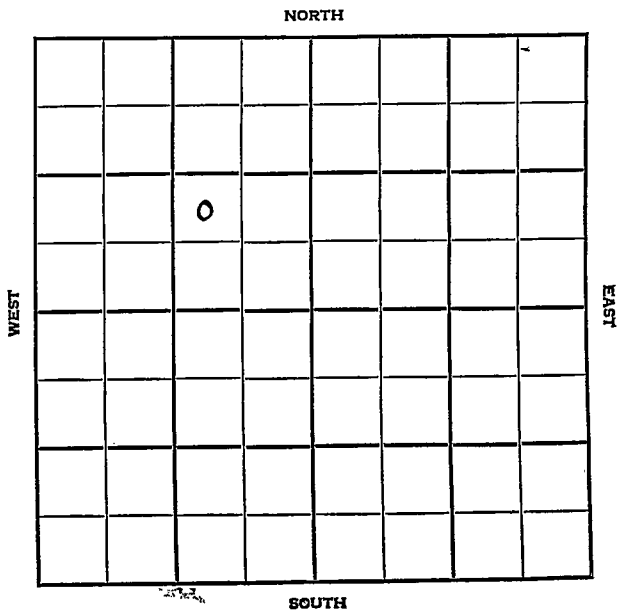

Cowley KANSAS

SEC.	TWP.	R.
36	32	4E

WELL NO. _____

1 Kittelson FARM

COMPANY

T. K. & E.

CONTRACTOR

Blackstock-Bradley & Dietz


Winfield Pool

_____ Ft. from N. Line

990 _____ Ft. from S. Line

990 _____ Ft. from E. Line

_____ Ft. from W. Line

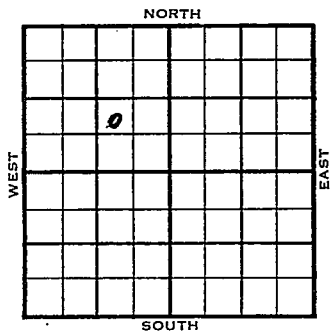

NW SE NW

	ELEVATION	REPORT
1954	1250'	

12/29
1955
1/12

RUR

Spud 12-27-54 D & A TD 2992
 8" @ 101 Stal. 1948 Layton 2400
 KC 2560 U swego 2756 Bart 2980
 TD 2992' D & A

ABANDONED

