

11-33-1E

12/24/84
KCC

Inc

STATE CORPORATION COMMISSION OF KANSAS
OIL & GAS CONSERVATION DIVISION

RECEIVED
Date: **JAN 1 1988**
WELL COMPLETION OR RECOMPLETION FORM
ACO-1 WELL HISTORY
FROM CONFIDENTIAL

DESCRIPTION OF WELL AND LEASE

Operator: License # 3068
Name Hazelwood Production & Exploration Co.
Address 6901 N. Broadway, Suite 320
City/State/Zip Oklahoma City, Okla. 73116

Purchaser: N/A

Operator Contact Person Jim Hazelwood, Jr.
Phone 405/848-6884

Contractor: License # 5840
Name Brandt Drilling Co., Inc

Wellsite Geologist Martin K. DuBois
Phone 316/221-0428

Designate Type of Completion
 New Well Re-Entry Workover
 Oil SWD Temp Abd
 Gas Inj Delayed Comp.
 Dry Other (Core, Water Supply etc.)

If OWWO: old well info as follows:
Operator
Well Name
Comp. Date Old Total Depth

WELL HISTORY

Drilling Method:
 Mud Rotary Air Rotary Cable
11-21-86 11-29-86 11-30-86
Spud Date Date Reached TD Completion Date
4150'
Total Depth PBDT

Amount of Surface Pipe Set and Cemented at 250 feet
Multiple Stage Cementing Collar Used? Yes No
If yes, show depth set feet
If alternate 2 completion, cement circulated from feet depth to w/ SX cmt


API NO. 15-191-21-964
County: Sumner
East West
C. NE. SW. Sec. 11. Twp. 33S Rge. 1

2050 Ft North from Southeast Corner of Section
3405 Ft West from Southeast Corner of Section
(Note: Locate well in section plat below)

Co. HAGGARD
Lease Name Well # 1
Field Name

Producing Formation: N/A

Elevation: Ground 1143 KB 1148
Section Plat

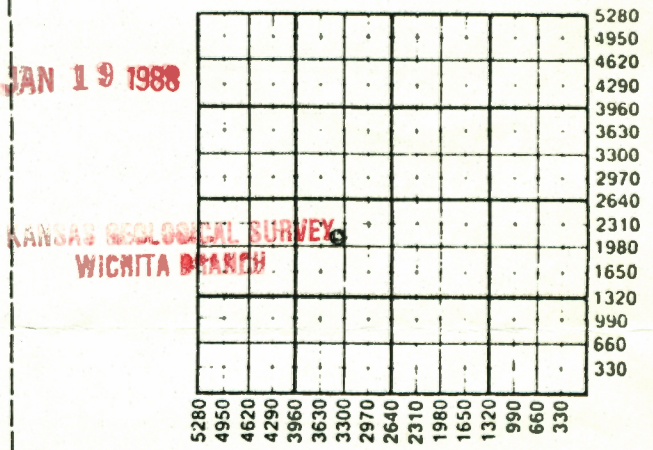

WATER SUPPLY INFORMATION
Disposition of Produced Water: Disposal Repressuring
Docket #

Questions on this portion of the ACO-1 call:
Water Resources Board (913) 296-3717

Source of Water:
Division of Water Resources Permit #
 Groundwater Ft North from Southeast Corner (Well) Ft West from Southeast Corner of Sec Twp Rge East West
 Surface Water Ft North from Southeast Corner (Stream, pond etc) Ft West from Southeast Corner creek Sec 11 Twp 33S Rge 1 East West
 Other (explain) (purchased from city, R.W.D. #)

INSTRUCTIONS: This form shall be completed in duplicate and filed with the Kansas Corporation Commission, 200 Colorado Derby Building, Wichita, Kansas 67202, within 90 days after completion or recompletion of any well. Rule 82-3-130 and 82-3-107 apply.
Information on side two of this form will be held confidential for a period of 12 months if requested in writing and submitted with the form. See rule 82-3-107 for confidentiality in excess of 12 months.

11-33-11

546757

SIDE TWO

Operator Name Hazelwood Production & Exploration Company Lease Name Haggard Well #. 1

Sec. 11 Twp. 33S Rge. 1 East West County Sumner

WELL LOG

INSTRUCTIONS: Show important tops and base of formations penetrated. Detail all cores. Report all drill stem tests giving interval tested, time tool open and closed, flowing and shut-in pressures, whether shut-in pressure reached static level, hydrostatic pressures, bottom hole temperature, fluid recovery, and flow rates if gas to surface during test. Attach extra sheet if more space is needed. Attach copy of log.

Drill Stem Tests Taken [] Yes [X] No
Samples Sent to Geological Survey [X] Yes [] No
Cores Taken [] Yes [X] No

Formation Description [X] Log [] Sample

Table with 3 columns: Name, Top, Bottom. Rows include Topeka, Heebner, Iatan, Stalnaker, Kansas City, Checkerboard, Marmaton, Mississippi, Simpson, Arbuckle.

CASING RECORD [X] New [] Used

Report all strings set-conductor, surface, intermediate, production, etc.

Table with 8 columns: Purpose of String, Size Hole Drilled, Size Casing Set (in O.D.), Weight Lbs/Ft., Setting Depth, Type of Cement, #Sacks Used, Type and Percent Additives. Row 1: Surface, 12 1/2, 8 5/8, 24#, 250, Common, 185, 2% Gel, 1/2% FloSeal.

PERFORATION RECORD

Acid, Fracture, Shot, Cement Squeeze Record

Table with 4 columns: Shots Per Foot, Specify Footage of Each Interval Perforated, (Amount and Kind of Material Used), Depth. Includes empty rows for data entry.

TUBING RECORD Size Set At Packer at Liner Run [] Yes [] No