

AFFIDAVIT OF COMPLETION FORM

12-33-1E

ACO-1

*Sub*

This form shall be filed ~~in~~ **triplicate** with the Kansas Corporation Commission, 200 Colorado Derby Building, Wichita, Kansas 67202, within **ten** days after the completion of the well, regardless of how the well was completed. Circle one: Oil, gas, dry SWD, OWWO, injection. Type and complete ALL sections. Applications must be filed for dual completion, commingling, salt water disposal and injection. Attach wireline logs (i.e. electrical log, sonic log, gamma ray neutron log, etc.) KCC#-(316)263-3238.

OPERATOR Carr Explorations, Inc. #5730  
 ADDRESS 124 S. Baltimore, Suite B  
P. O. Box 622  
Derby, Kansas 67037

API NO. 15-191-21,463  
 COUNTY Sumner  
 FIELD \_\_\_\_\_

\*\*CONTACT PERSON Gary E. Caruthers  
 PHONE 788-2897

PROD. FORMATION NA  
 LEASE Sauzek "A"

PURCHASER NA  
 ADDRESS \_\_\_\_\_


*State Geological Survey  
 WICHITA BRANCH*

WELL NO. 1  
 WELL LOCATION SW SE NE

DRILLING CONTRACTOR McAllister Drilling Co.  
 ADDRESS 251 North Water, Suite 10  
Wichita, Kansas 67202

330 Ft. from SOUTH Line and  
990 Ft. from EAST Line of  
 the NE SEC. 12 TWP. 33 RGE. 1E

PLUGGING CONTRACTOR United Cementing & Acid Co., Inc.  
 ADDRESS P. O. Box 712  
El Dorado, Kansas 67042

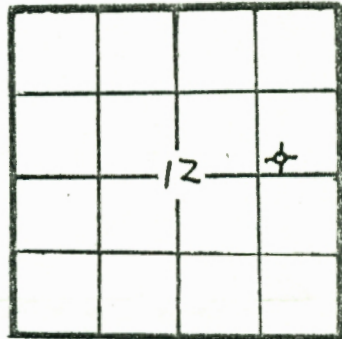

WELL PLAT

KCC \_\_\_\_\_  
 KGS \_\_\_\_\_  
 MISC   
 (Office Use)

TOTAL DEPTH 3406 PBTD \_\_\_\_\_  
 SPUD DATE 10/23/82 DATE COMPLETED 10/30/82  
 ELEV: GR 1123 DF 1126 KB 1128

DRILLED WITH (CABLE) ROTARY (AIR) TOOLS  New / (Used) casing.  
 CASING RECORD

Report of all strings set — surface, intermediate, production, etc.

Purpose of string	Size hole drilled	Size casing set (in O.D.)	Weight lbs/ft.	Setting depth	Type cement	Sacks	Type and percent additives
Surface	12 1/4"	8 5/8"		300'	Common	160	3% CC

LINER RECORD

PERFORATION RECORD

Top, ft.	Bottom, ft.	Sacks cement	Shots per ft.	Size & type	Depth interval

TUBING RECORD

Size	Setting depth	Pecker set at

31-22-6

Name of lowest fresh water producing stratum \_\_\_\_\_ Depth \_\_\_\_\_

Estimated height of cement behind Surface Pipe TO SURFACE.

DV USED? \_\_\_\_\_

12-33-1e

WELL LOG

Formation Description, Contents, etc.	Top	Bottom	Name	Depth
Shale				1195'
Shale and Lime				1767'
Lime and Shale				3071'
Lime				3199'
Lime and Shale				3406'

A F F I D A V I T

STATE OF Kansas, COUNTY OF Sedgwick SS, \_\_\_\_\_

Gary E. Caruthers OF LAWFUL AGE, BEING FIRST DULY SWORN UPON HIS OATH,  
DEPOSES THAT HE IS President ~~XXX~~ (OF) Carr Explorations, Inc.

OPERATOR OF THE Sauzek "A" LEASE, AND IS DULY AUTHORIZED TO MAKE

THIS AFFIDAVIT FOR AND ON THE BEHALF OF SAID OPERATOR, THAT WELL NO. 1 ON