

MAR 18 1985 *Inc*

SIDE ONE

STATE CORPORATION COMMISSION OF KANSAS  
OIL & GAS CONSERVATION DIVISION

WELL COMPLETION OR RECOMPLETION FORM  
ACO-1 WELL HISTORY

DESCRIPTION OF WELL AND LEASE

Operator: License # 5601  
Name Associated Petroleum Consultants, Inc.  
Address Suite 600 - One Main Place  
City/State/Zip Wichita, KS 67202

Purchaser None

Operator Contact Person Steve Wisotsky  
Phone 265-9385

Contractor: License # 5867  
Name Heartland Drilling, Inc.

Wellsite Geologist Paul C. Caragianis  
Phone 265-9385

Designate Type of Completion  
 New Well     Re-Entry     Workover  
 Oil     SWD     Temp Abd  
 Gas     Inj     Delayed Comp  
 Dry     Other (Core, Water Supply etc.)

If OWNO: old well info as follows:  
Operator .....  
Well Name .....  
Comp. Date ..... Old Total Depth.....

WELL HISTORY

Drilling Method:  
 Mud Rotary     Air Rotary     Cable  
..2/27/85..    ..3/8/85.....    ..3/8/85.....  
Spud Date    Date Reached TD    Completion Date  
..4430!.....    ..NA.....  
Total Depth    PBDT

Amount of Surface Pipe Set and Cemented at 256 feet  
Multiple Stage Cementing Collar Used?  Yes  No  
If yes, show depth set.....feet  
If alternate 2 completion, cement circulated  
from.....feet depth to.....w/.....SX cmt  
Alternate 1 used.

API NO. 15-.....191-21,796.....

**31-33-1E**  
*State Geological Survey*

County.....Sumner.....**WICHITA BRANCH**  
 East  
..C.. SW.. NE.. Sec.. 31 Twp.. 33 Rge.. 1..  West

.....3300..... Ft North from Southeast Corner of Section  
.....1980..... Ft West from Southeast Corner of Section  
(Note: Locate well in section plat below)


Lease Name.....Thorpe..... Well # 1.....

Field Name.....Wildcat.....

Producing Formation.....D & A.....

Elevation: Ground.....1209'.....KB.....1219'.....

Section Plat

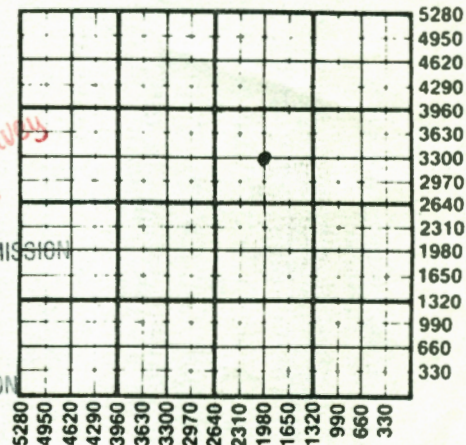

**RECEIVED**  
STATE CORPORATION COMMISSION  
**WICHITA BRANCH**  
MAY 22 1985  
MAR 12 1985

**WATER SUPPLY INFORMATION**

Disposition of Produced Water:  Disposal  
Docket # .....  Repressuring

Questions on this portion of the ACO-1 call:  
Water Resources Board (913) 296-3717

Source of Water:  
Division of Water Resources Permit # NA.....

Groundwater.....Ft North from Southeast Corner  
(Well) .....Ft West from Southeast Corner of  
Sec Twp Rge  East  West

Surface Water 3300 Ft North from Southeast Corner  
(Stream, pond etc) 1650 Ft West from Southeast Corner  
Sec 31 Twp 33 Rge 1  East  West

Other (explain).....  
(purchased from city, R.W.D. #)

INSTRUCTIONS: This form shall be completed in duplicate and filed with the Kansas Corporation Commission, 200 Colorado Derby Building, Wichita, Kansas 67202, within 90 days after completion or recompletion of any well. Rule 82-3-130 and 82-3-107 apply.

Information on side two of this form will be held confidential for a period of 12 months if requested in writing and submitted with the form. See rule 82-3-107 for confidentiality in excess of 12 months. One copy of all wireline logs and drillers time log shall be attached with this form. Submit CP-4 form with all plugged wells. Submit CP-111 form with all temporarily abandoned wells.

31-33-1E

Operator Name Associated Petroleum Consultants, Inc. Lease Name Thorpe Well # 1

Sec. 31 Twp. 33 Rge. 1 East West County Summer

WELL LOG

INSTRUCTIONS: Show important tops and base of formations penetrated. Detail all cores. Report all drill stem tests giving interval tested, time tool open and closed, flowing and shut-in pressures, whether shut-in pressure reached static level, hydrostatic pressures, bottom hole temperature, fluid recovery, and flow rates if gas to surface during test. Attach extra sheet if more space is needed. Attach copy of log.

Drill Stem Tests Taken [ ] Yes [X] No
Samples Sent to Geological Survey [ ] Yes [X] No
Cores Taken [ ] Yes [X] No

Formation Description [X] Log [ ] Sample

Table with 4 columns: FROM, TO, DESCRIPTION, Name, Top, Bottom. Lists geological formations like Topeka, Lacompton, Heebner, etc. with depth intervals.

Red stamps: MAR 18 1985, MAY 22 1985, RECEIVED STATE CORPORATION COMMISSION, MAR 12 1985, CONSERVATION DIVISION Wichita, Kansas

CASING RECORD, PERFORATION RECORD, TUBING RECORD, Date of First Production, Producing Method. Includes checkboxes for New/Used casing and various production options.