


Section 10 Township 33 Range 10-E

Well Number 1 Wells

Company A. Hough & Wentz

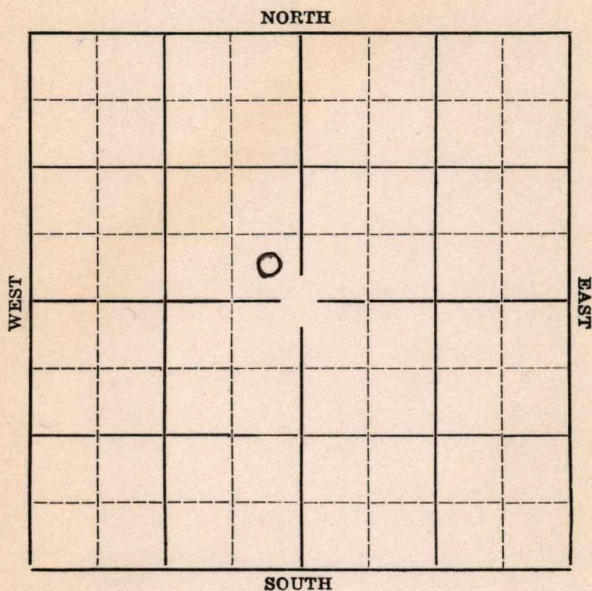

1937

7/14

6" @ 1835'.

Sil. 2315'.

T.D. 2328'.

ABANDONED

Chart **KANSAS**Map No. 4 Sec. 10 Twp. 33 R. 10^EWell No. 1-WellsHough & Wentz Company
Contractor**ABANDONED****SECTION PLAT**

	0		

_____ Ft. from N. Line

330 Ft. from S. Line330 Ft. from E. Line

_____ Ft. from W. Line

Location _____

Rig up _____

Drilling and Remarks:

D & A

RECORDCased 6 in., 1835 ft.Sand 511 2315

Gas _____

Oil _____

Total Depth 2328**PRODUCTION**

1st 24 hrs. Nat. _____

1st 24 hrs. after shot _____

Gas _____ Cu. Ft.

Dry Hole _____

Abandoned _____

Date

JUL 14 1937

19

H. D. Hatfield Scout

Chanauqua **KANSAS**Map No. 4 Sec. 10 Twp. 33 R. 10 EWell No. 1 WellsC. Hough & Hentz Company
Contractor

SECTION PLAT

 Ft. from N. Line380 Ft. from S. Line330 Ft. from E. Line Ft. from W. Line

FIRST REPORT

Location Rig up

Drilling and Remarks:

Wack

RECORD

Cased in., ft.Sand Gas Oil Total Depth

PRODUCTION

1st 24 hrs. Nat. 1st 24 hrs. after shot Gas Cu. Ft.Dry Hole Abandoned

Date

MAR 10 1937

19

S. J. LEWIS

Scout