


Section..... 10 Township..... 33 Range..... 13-E

Well Number..... 1 - Hayes

Company..... Buffington & Coen

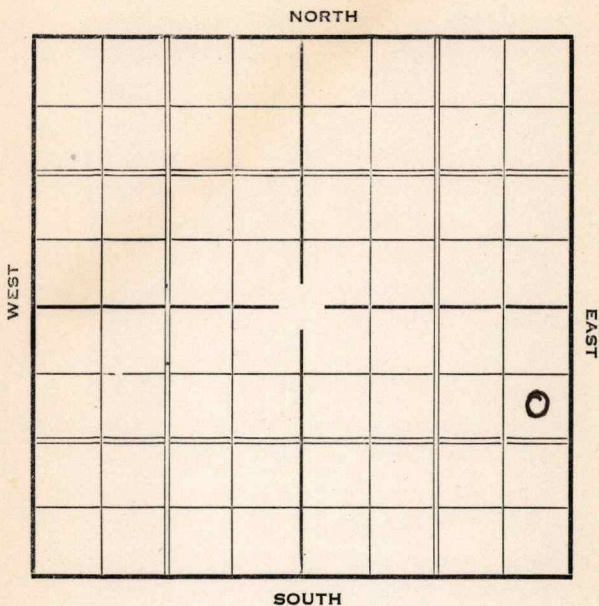

Sec. 10 Twp. 33 R. 13-E

Well No. #1 Hayes Farm


Buffington & Coen Company

990 Ft. from N. Line

_____ Ft. from S. Line

330 Ft. from E. Line

_____ Ft. from W. Line

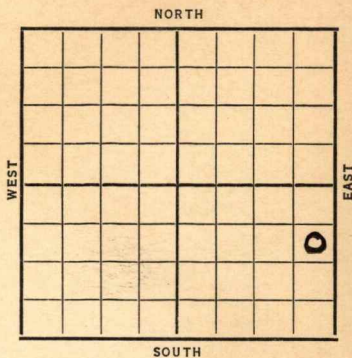

Date	REPORT
1937	
5/19	Est. 300,000 gas @ 647'. 8" @ 985'.
	Drlg. 1025'.
5/28	Drlg. 1537'.
6/4	T.D. 1617'. U.R. 6".
6/11	" " " "
6/19	Miss. 1525'. 6" @ 1630'. Drlg. 1786'.
6/23	6" @ 1630'. Sil. 1795'.
	T.D. 1808'.
	ABANDONED

KANSAS

Chautauqua

Map No. *MM* Sec. *10* Twp. *33* R. *13E*

Well No. *1 - Hayes*

Buffington & Coen Company
Contractor

FIRST REPORT

SECTION PLAT

990 Ft. from N. Line

_____ Ft. from S. Line

330 Ft. from E. Line

_____ Ft. from W. Line

			<i>0</i>

Location _____

Rig up _____

Drilling and Remarks:

est. - 300,000 gas @ 647

8" - 985

Dlg - 1025

RECORD

Cased _____ in., _____ ft.

Sand _____

Gas _____

Oil _____

Total Depth _____

PRODUCTION

1st 24 hrs. Nat. _____

1st 24 hrs. after shot _____

Gas _____ Cu. Ft.

Dry Hole _____

Abandoned _____

Date

MAY 19 1937 19

H. D. Hatfield Scout

Chaut **KANSAS**

Map No. WOMY Sec. 10 Twp. 33 R. 13 ^E

Well No. 1-Hayes

Buffington & Co. Company
Contractor

ABANDONED

SECTION PLAT

990 Ft. from N. Line

_____ Ft. from S. Line

330 Ft. from E. Line

_____ Ft. from W. Line

			0

Location _____

Rig up _____

Drilling and Remarks:

D+A

RECORD

Cased 6 in., 1630 ft.

Sand 511 1795

Gas _____

Oil _____

Total Depth 1808

PRODUCTION

1st 24 hrs. Nat. _____

1st 24 hrs. after shot _____

Gas _____ Cu. Ft.

Dry Hole _____

Abandoned _____

Date

JUN 23 1937 19

H. D. Hatfield Scout