

Cowley


KANSAS

FORM 51 25M 3-49 PETROL

Section 12 Township 33 Range 5E

Well No. #1 Maddix

Company Greeley Drlg.

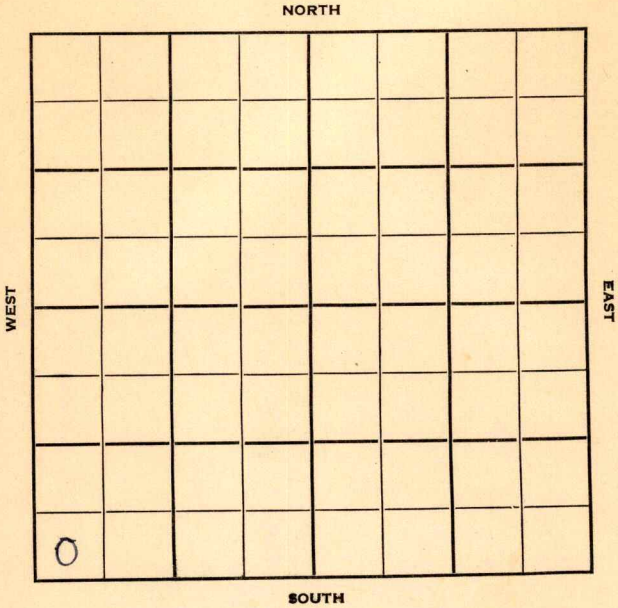

Cowley

KANSAS



Sec. 12 Twp. 33 R. 5E

Well No. #1 Maddix Farm

Greeley Drlg. Company

MCPC N/2 NE sec. 12 Contractor

Wildcat

 Ft. from N. Line


330' Ft. from S. Line

 Ft. from E. Line

330' Ft. from W. Line

SW SW SW

Twin Well

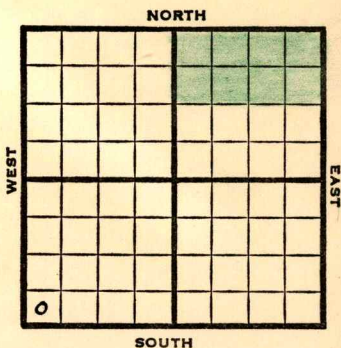

1950

Elev 1261

REPORT

4/12

Location

5/24

TD 3114

8 5/8" @ 80

Miss 3081

5" @ 3089

3 qt 3089-95

3 qt 3110- SSO

DD 3114

15 qt

Fu 120' oil

D&A

ABANDONED

Kansas

Wildcat

Map No. _____ Sec. 12 Twp. 33 R. 5EWell No. 1 Maddix

Greeley Drlg. _____ Company

MCPC N/2 NE sec. 12 _____ Contractor


SW SW SW

SECTION PLAT

_____ Ft. from N. Line

330 Ft. from S. Line

_____ Ft. from E. Line

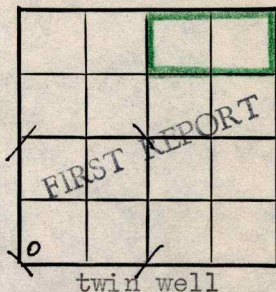330 Ft. from W. Line

Cowley County

RECORD

Location _____

Cased _____ in., _____ ft.

Rig up _____

Sand _____

Drilling and Remarks:

Gas _____

Oil _____

Total Depth _____

PRODUCTION

1st 24 hrs. Nat. _____

1st 24 hrs. after shot _____

Gas _____ Cu. Ft.

Dry Hole _____

Abandoned _____

Date

APR 12 1950 19J. E. TYRA

Scout

Kansas

Map No. _____ Sec. 12 Twp. 33 R. 5EWell No. 1 Maddix

Greeley Drlg. _____ Company _____

Contractor _____

SW SW SW

E1.1261
SECTION PLAT

_____ Ft. from N. Line

330 Ft. from S. Line

_____ Ft. from E. Line

330 Ft. from W. Line

Cowley

Location _____

Rig up _____

Drilling and Remarks:

8 5/8" c 80miss 30815" c 3089~~I.D. 3095~~3 qt. 3089-953 qt. 3110 550DD 311415 qt.

RECORD

Cased _____ in., _____ ft.

Sand _____

Gas _____

Oil _____

Total Depth ~~3095~~ 3114

PRODUCTION

1st 24 hrs. Nat. _____

1st 24 hrs. after shot _____

Gas _____ Cu. Ft.

Dry Hole _____

Abandoned _____

Date

MAY 24 1950

19

J. E. TYRA Scout

74. 120' il

D + A

JUN 5 - 1950

Scout Cards
Land Small Map
Land Wall Map
Tracings
France Map
Pierce Map
Misc.

W M

Produced

on

at

and

by











