


Cowley

Section 12 Township 33 Range 4E

Well No. 2 Johnson

Company J. B. O'Quinn

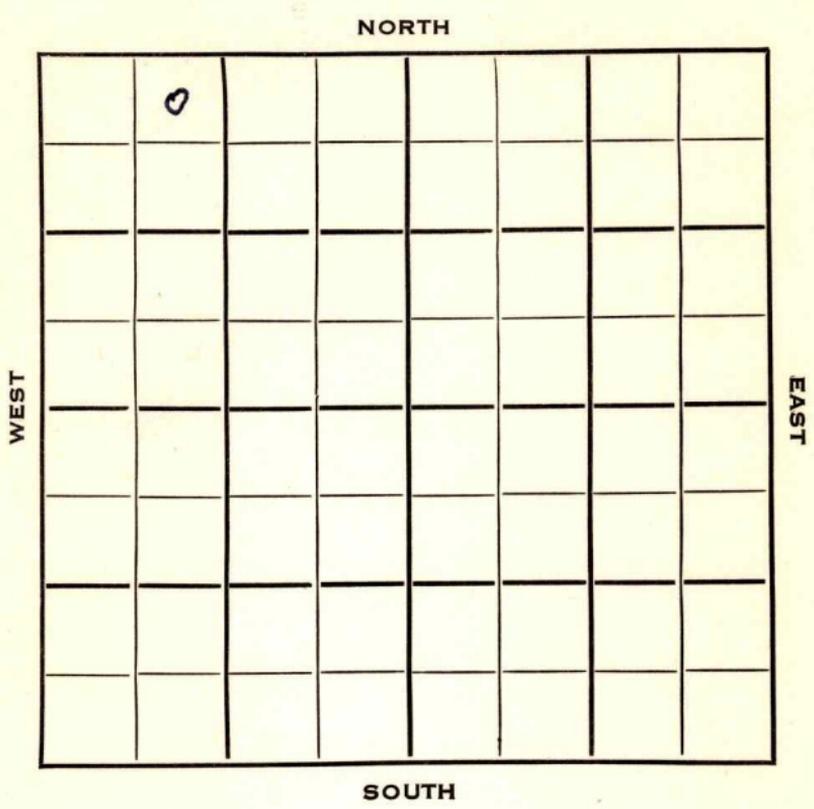

Cowley KANSAS

SEC. 12	TWP. 33	R. 4E ✓
------------	------------	------------


WELL NO. 2 Johnson FARM

COMPANY J. B. O'Quinn

CONTRACTOR Lehmann

330 Tisdale Gas Pool

\_\_\_\_\_ Ft. from N. Line  
 \_\_\_\_\_ Ft. from S. Line  
 \_\_\_\_\_ Ft. from E. Line  
 990 \_\_\_\_\_ Ft. from W. Line

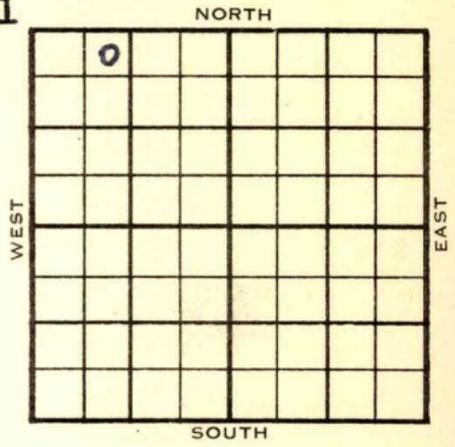

NE NW NW

1953	ELEVATION 1218'	REPORT
------	--------------------	--------

11/11 Spud 11-2-53  
 15" @ 390'  
 Drlg. 810'

1954  
 3/17 Spud 11-2-53 Oil well TD 1770  
 15" @ 390 13" @ 840 Peacock 1418  
 Hoover 1755 TD 1770 GO to 1770  
 5" @ 1755 sd-frac.  
 Comp. 50 BOPD

**COMPLETED**

County Cowley State Kansas

Sec. 12 (Blk. 33 (Sur. Rge.) 4E) Map No.

Operator J. B. O'Quinn

Well No. 2 Farm Johnson

Elev. \_\_\_\_\_ Location NE NW NW

	o				

330 Ft. From N Line NW

990 Ft. From W Line Quarter

1st. Report NOV 11 1953

Completion \_\_\_\_\_

Remarks \_\_\_\_\_

Lehmann - Contr.

Spudding Date 11-2-53

Drlg. Data Tisdale Gas Pool

15" @ 390 drlg. 810

County Cowley State Kansas

Sec. 12 (Blk. 33 (Sur. 4E (Twp.) 4E Map No.

Operator J. B. O'Quinn

Well No. 2 Farm Johnson

Elev. 1218 Location NE NW NW

0					

330 Ft. From N Line NW

990 Ft. From W Line Quarter

1st. Report

Completion MAR 17 1954

Remarks Tisdale gas Pool

Lehmann - Contr.

Spudding Date 11-2-53

Drlg. Data Oil well TD 1770

15" @ 390 13" @ 840 Peacock 1418

Hoover 1755 TD 1770 CO to 1770

5" @ 1755 sd-frac Comp. 50 bopd

J. G. McGEHEE