


Give All Information Completely
Make Required Affidavit
Mail or Deliver Report to:
Conservation Division
State Corporation Commission
800 Bittling Building
Wichita, Kansas

FORMATION PLUGGING RECORD

Strike out upper line
when reporting plug-
ging off formations.

NORTH

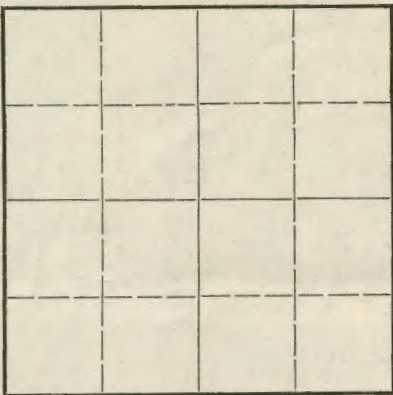

Locate well correctly on above
Section Plat

Cowley

County. Sec. 14 Twp. 33 Rge. 6 (E) (W)
S.W. Corner S.E. 1/4 of S.W. 1/4

Location as "NE 1/4 NW 1/4 SW 1/4" or footage from lines

Lease Owner

Fresh

Lease Name

Tulsa, Okla.

Well No.

Office Address

Character of Well (completed as Oil, Gas or Dry Hole)

Dry

Date well completed

10-27-46

19

Application for plugging filed

10-27-46

19

Application for plugging approved

10-27-46

19

Plugging commenced

10-27-46

19

Plugging completed

10-28-46

19

Reason for abandonment of well or producing formation

Dry

If a producing well is abandoned, date of last production

19

Was permission obtained from the Conservation Division or its agents before plugging was com-
menced? Yes

W. S. Lemaster

Name of Conservation Agent who supervised plugging of this well

Producing formation

Depth to top

Bottom

Total Depth of Well

Feet

Show depth and thickness of all water, oil and gas formations.

OIL, GAS OR WATER RECORDS

CASING RECORD

Formation	Content	From	To	Size	Put In	Pulled Out
Skinner	Dry	2786	2797			
Bartlesville	Dry	2873	2920			
Chat	Dry	2968	2952			
		0	100	8 5/8	Casing Left In	

Describe in detail the manner in which the well was plugged, indicating where the mud fluid was placed and the method or methods used in introducing it into the hold. If cement or other plugs were used, state the character of same and depth placed, from feet to feet for each plug set.

Mud from 2992' to 165'

Cement 165' to 140'

Mud 140' to 25'

Cement 25' to 0'

OWLL

(If additional description is necessary, use BACK of this sheet)

Correspondence regarding this well should be addressed to

Address

STATE OF Kansas
L. W. Burns

COUNTY OF

Cowley

ss.

(employee of owner) or (owner or operator) of the above-described well,
being first duly sworn on oath, says: That I have knowledge of the facts, statements, and matters herein contained and the log of the above-
described well as filed and that the same are true and correct. So help me God.

(Signature)

E. W. Burns

816 E. 10th St.,

Winfield, Kans.

(Address)

SUBSCRIBED AND SWORN to before me this 3rd day of December, 1946

Walter C. Bailey

Notary Public.

My commission expires

June 17, 1947