


Section 14 Township 33 Range 6-E

Well No. #1, Fresh (48 Strat)

Company B. B. Blair etal

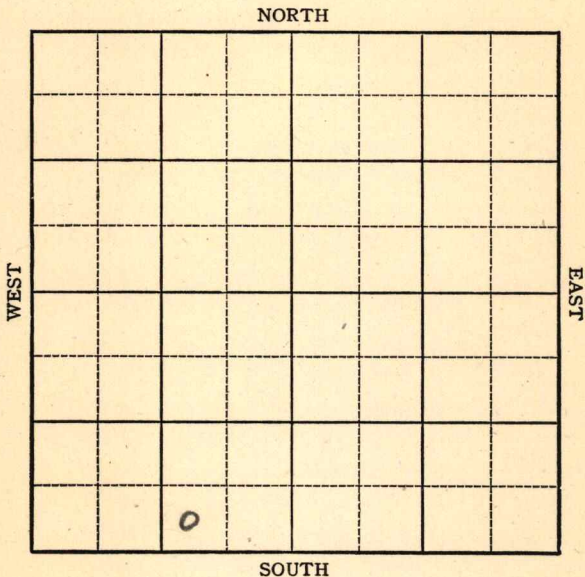

KANSAS

Sec. 14 Twp. 33 R. 6-E

Well No. #1, Fresh (48 Strat) Farm

B. B. Blair etal Company


Wildcat

Ft. from N. Line

330' Ft. from S. Line

990' Ft. from E. Line

Ft. from W. Line

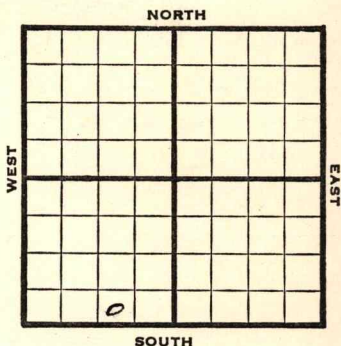

SW SE SW

1946

Elev. 1246

REPORT

12/4

Lans 2096'
B.V. Zone 2878-2920'
Cong. 2963-66
Chat 2966
2992' TD in Miss.
D&A.

FIRST REPORT
+
ABANDONED

Map No. Sec. 14 Twp. 33 R. 6EWell No. 1 Fresh (48 Strat)B.B. Blair et al. Company


FIRST REPORT

Contractor

SW SE SW

ABANDONED

SECTION PLAT

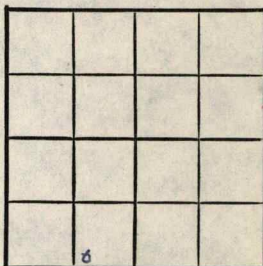 Ft. from N. Line330 Ft. from S. Line990 Ft. from E. Line Ft. from W. LineCowley CountyLocation Rig up

Drilling and Remarks:

Lans. 2096

B.V. Zone 2878-2920

Cong. 2963-66

Chat. 2966

2992 TD in Miss

D & A

RECORD

Cased in., ft.Sand Gas Oil Total Depth

PRODUCTION

1st 24 hrs. Nat. 1st 24 hrs. after shot Gas Cu. Ft.Dry Hole Abandoned

Date

19S. J. LEWIS Scout