


Section 14 Township 33 Range 12E

Well Number 10 "A" Willson

Company Sagamore et al

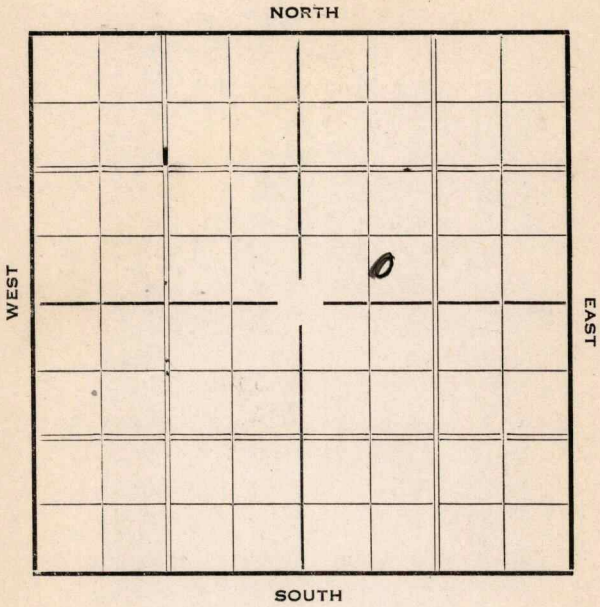

Form 252A-5M-5-28-Mid-West **KANSAS** Chautauqua

Map No. _____ Sec. 14 Twp. 33 R. 12E

Well No. 10. "A" Willson Farm


Sagamore et al Company

-----Ft. from N. Line

619 Ft. from S. Line

Ft. from E. Line

701 Ft. from W. Line

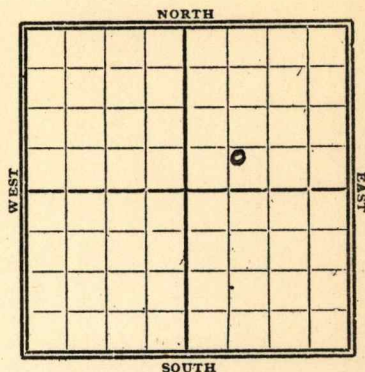

Date
1936

REPORT

12/9	Spud
------	------

12/17	Drlg. 610'.
-------	-------------

12/24 Oswego 1215'. Drlg. 1265'.

12/29 Drlg. 1265'.

1937

1/7	Drl g. 1843'.
-----	---------------

1/14	"	"
------	---	---

1/20	Sil. 1873'. T. D. 1874'.
------	--------------------------

Estimated 20 bbls.

COMPLETED

KANSASMap No. 4 Sec. 14 Twp. 33 R. 12EWell No. 10 "A" WilsonSagamore & Co. Company

Contractor

SECTION PLAT

		0	

_____ Ft. from N. Line

619 Ft. from S. Line

_____ Ft. from E. Line

701 Ft. from W. Line**FIRST REPORT**

Location _____

Rig up _____

Drilling and Remarks:

Spud**RECORD**

Cased _____ in., _____ ft.

Sand _____

Gas _____

Oil _____

Total Depth _____

PRODUCTION

1st 24 hrs. Nat. _____

1st 24 hrs. after shot _____

Gas _____ Cu. Ft.

Dry Hole _____

Abandoned _____

Date

DEC 9 1936 19S. J. LEWIS

Scout

Map No. 4 Sec. 14 Twp. 33 R. 12 E

Well No. 10 @ H. Wilson

Sagamore Company

Contractor

SECTION PLAT

		0	

 Ft. from N. Line

619 Ft. from S. Line

 Ft. from E. Line

701 Ft. from W. Line

COMPLETED

Location

Rig up

Drilling and Remarks:

Oil 1873

Estimated

20886.

RECORD

Cased in., ft.

Sand

Gas

Oil

Total Depth 1874

PRODUCTION

1st 24 hrs. Nat.

1st 24 hrs. after shot

Gas Cu. Ft.

Dry Hole

Abandoned

Date

JAN 20 1937 19

S. J. LEWIS Scout