


Section 14 Township 33 Range 12E

Well Number 9 "A" Willson


Company Sagamore et al

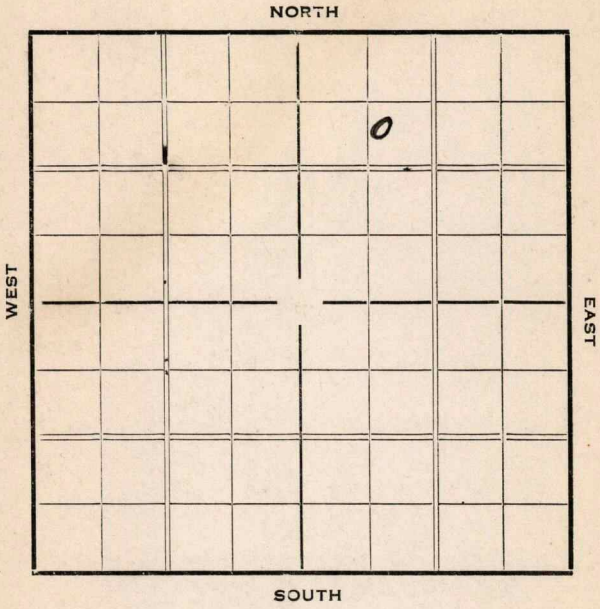

Map No. Sec. 14 Twp. 33 R. 12E

Well No. 9 "A" Willson Farm
 Sagamore et al Company

..... 1021 Ft. from N. Line
 Ft. from S. Line
 Ft. from E. Line
 701 Ft. from W. Line

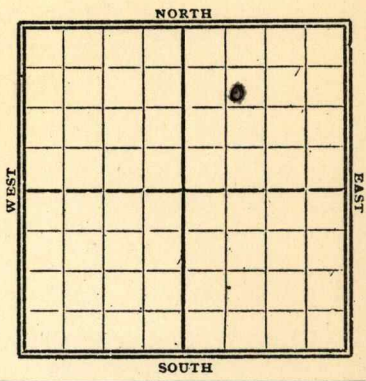

Date	REPORT
1936	
12/9	Spud
12/17	Drlg. 575'.
12/24	Oswego 1136'. Drlg. 1175'.
12/29	Drlg. 1175'.
1937	
1/7	Sil. 1772'. T. D. 1779'.
	1000' oil in hole.
1/14	" " " "
1/20	Sil. 1772'. T. D. 1779'.
	18 bbls.

COMPLETED

Map No. 4 Sec. 14 Twp. 33 R. 12E

Well No. 9 "A" William

Sagamore & Co Company

Contractor

SECTION PLAT

		0	

1021 Ft. from N. Line

_____ Ft. from S. Line

_____ Ft. from E. Line

701 Ft. from W. Line

COMPLETED

Location _____

Rig up _____

Drilling and Remarks:

Sil 1772
18 1/2 h.

RECORD

Cased _____ in., _____ ft.

Sand _____

Gas _____

Oil _____

Total Depth 1779

PRODUCTION

1st 24 hrs. Nat. _____

1st 24 hrs. after shot _____

Gas _____ Cu. Ft.

Dry Hole _____

Abandoned _____

Date

JAN 20 1937 19

S. J. LEWIS Scout

KANSAS

Map No. 4 Sec. 14 Twp. 33 R. 12E

Well No. 9 "C" Hillson

Sagamore & Co. Company

J. Contractor

SECTION PLAT

		o	

1021 Ft. from N. Line

_____ Ft. from S. Line

_____ Ft. from E. Line

701 Ft. from W. Line

FIRST REPORT

Location _____

Rig up _____

Drilling and Remarks:

Spud

RECORD

Cased _____ in., _____ ft.

Sand _____

Gas _____

Oil _____

Total Depth _____

PRODUCTION

1st 24 hrs. Nat. _____

1st 24 hrs. after shot _____

Gas _____ Cu. Ft.

Dry Hole _____

Abandoned _____

Date

DEC 9 1936 19

S. J. LEWIS Scout