


Section 14 Township 33 Range 12-E

Well Number 11 "A" Willson

Company Sagmore O&G

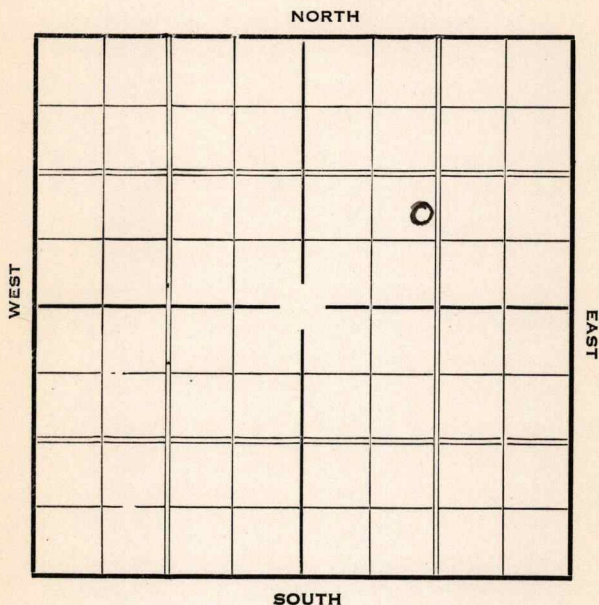

Sec. 14 Twp. 33 R. 12-E

Well No. #11 "A" Willson Farm


Sagmore O & G Company

 Ft. from N. Line

919 Ft. from S. Line

 Ft. from E. Line

1201 Ft. from W. Line

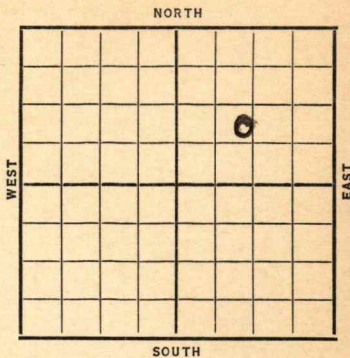

Date	REPORT
1937	
4/14	Location
4/23	"
4/30	Drlg. 450'.
5/7	Drlg. 520'.
5/14	Drlg. 1085'.
5/21	Miss. 1606'. Drlg. 1655'.
5/28	" " " " "
6/4	Sil. 1915'.
	SD 1937'.
6/11	T.D. 1950'. 5 B.W. P.B.
6/19	" " " "
6/23	Sil. 1915'.
	T.D. 1950' S.W.
	P.B. 1148 in Pink lime.
	1/4 M gas.
	COMPLETED

Chaut **KANSAS**

Map No. 4 Sec. 14 Twp. 33 R. 12 ^E

Well No. 11-A" Willson

Sagamore Company
Contractor

COMPLETED

SECTION PLAT

_____ Ft. from N. Line

919 Ft. from S. Line

_____ Ft. from E. Line

1201 Ft. from W. Line

		0	

Location _____

RECORD

Rig up _____

Cased _____ in., _____ ft.

Drilling and Remarks:

Sand 511 1915

P.B. 1148 in

Gas _____

Pink Lime

Oil _____

Total Depth 1950 SW

PRODUCTION

1/4 M gas

1st 24 hrs. Nat. _____

1st 24 hrs. after shot _____

Gas _____ Cu. Ft.

Dry Hole _____

Abandoned _____

Date

JUN 23 1937
JUN 23 1937 19

H. D. Hatfield Scout

KANSAS *Chautauqua*

Map No. 4 Sec. 14 Twp. 33 R. 12E

Well No. 11 "A" Wilson

Sagmore O & G. Company

Contractor

SECTION PLAT

		0	

_____ Ft. from N. Line

919 Ft. from S. Line

_____ Ft. from E. Line

1201 Ft. from W. Line

FIRST REPORT

Location ✓

Rig up _____

Drilling and Remarks:

RECORD

Cased _____ in., _____ ft.

Sand _____

Gas _____

Oil _____

Total Depth _____

PRODUCTION

1st 24 hrs. Nat. _____

1st 24 hrs. after shot _____

Gas _____ Cu. Ft.

Dry Hole _____

Abandoned _____

Date

APR 14 1937 19

S. J. LEWIS Scout