

Map No. _____ Sec. 17 Twp. 33 R. 5

Well No. 1 Newman Farm

Willard & Scott Company

NORTH

WEST

EAST

SOUTH

Location -----

Drilling Remarks:

Rig Up-----

Drilling Remarks:

RECORD

Cased _____ in. _____ ft.

Sand _____

Gas _____

Oil _____

Total Depth -----

PRODUCTION

1st 24 hrs. Nat. -----

1st 24 hrs. after shot-----

Gas -----cu. ft.

Dry Hole_____

Abandoned-----

Map No. _____ Sec. 17 Twp. 33 R. 5


Well No. #1 Newman Farm
Hillard & Scott Company

Ft. from N. Line

660 Ft. from S. Line

Ft. from E. Line

660 Ft. from W. Line

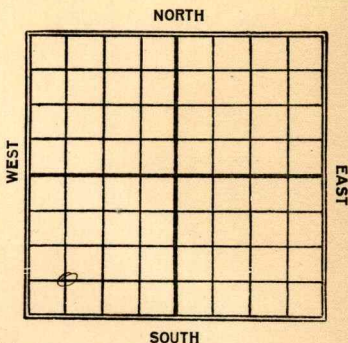

Date _____

REPORT

Date
1922

7/2 n

1923

4/7

Spudding
D. + G. 2909'

Map No. KV Sec. 17 Twp. 33 R. 5Well No. 1 NewmanWittard & Scott Company

Contractor

SECTION PLAT

FIRST REPORT

Ft. from N. Line

660' Ft. from S. Line

Ft. from E. Line

660' Ft. from W. Line

Location

Rig up

Drilling and Remarks:

spud

RECORD

Cased _____ in., _____ ft.

Sand _____

Gas _____

Oil _____

Total Depth _____

PRODUCTION

1st 24 hrs. Nat. _____

1st 24 hrs. after shot _____

Gas _____ Cu. Ft.

Dry Hole _____

Abandoned _____

Date

JUL 27 1922

M. A. BENEAR

191

Scout

Map No. **KANSAS** 2 Sec. 17 Twp. 33 R. 5
 Well No. 1 Newman
 Willard & Scott Company
 Contractor

ABANDONED SECTION PLAT

Ft. from N. Line

660 Ft. from S. Line

Ft. from E. Line

660 Ft. from W. Line

0			

Location

Rig up

Drilling and Remarks:

2049
 2909'

RECORD

Cased in., ft.

Sand

Gas

Oil

Total Depth

PRODUCTION

1st 24 hrs. Nat.

1st 24 hrs. after shot

Gas Cu. Ft.

Dry Hole

Abandoned

Date APR 7 1923

M. A. BENEAR

191 Scout