

Cowley

KANSAS

SECTION 17 TOWNSHIP 33 RANGE 6E

WELL NO. #1 Lamb

COMPANY Time Petroleum

NORTH

				0			

WEST

EAST

SOUTH

Cowley

KANSAS

SEC.	TWP.	R.
17	33	6 E

WELL NO. #1 Lamb FARM

COMPANY Time Petroleum

CONTRACTOR Kirkpatrick

Wildcat


\_\_\_\_\_ FT. FROM N. LINE

\_\_\_\_\_ FT. FROM S. LINE

\_\_\_\_\_ FT. FROM E. LINE

\_\_\_\_\_ FT. FROM W. LINE

SW NW SE

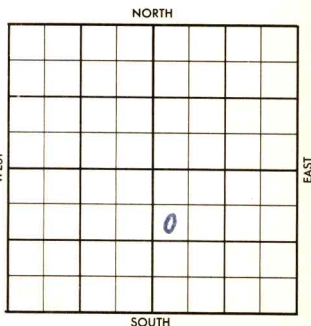

SDX - 1/4 Mile

1956	ELEVATION	REPORT
	1296 KB	

5/23 Comm. 5-18-56  
8" @ 80/70  
Drlg. 2354'

5-29 D&A  
Stall 1847', Stall Sd. 1866',  
Hog sh. 2271', Lay. 2298', KC. 2492',  
Osw. 2690', Ce. 2838', M. 3081'.  
TD 3158'

ABANDONED

County Cowley Elev. 1296 KB  
 Sec. 17 Twp. 33 Rge. 6E  
 Company Time Petroleum  
 Farm Name Lamb No. 1

	TOPS	DEPTH	LOG	DATUM
Anh.				
Tp.	<u>Stall</u>	<u>1847</u>		<u>551</u>
H.	<u>" 3rd</u>	<u>1866</u>		<u>572</u>
Tr.	<u>Hogsh.</u>	<u>2271</u>		<u>925</u>
Dg.	<u>Ldy</u>	<u>2292</u>		<u>1022</u>
Bl.				
L.				
K.C.		<u>2492</u>		<u>1196</u>
B.K.C.	<u>OSW</u>	<u>2690</u>		<u>1394</u>
Ce.		<u>2838</u>		<u>1542</u>
C.				
M.		<u>3081</u>		<u>1745</u>
M.				
K.				
Mz.				
Mo.				
V.				
S.				
S.				
A.				
R.				
PE.				
G.				
TD.		<u>3158</u>		

Loc. in Sec. SW NW SE

Geol. \_\_\_\_\_  
 Contr. Kirkpatrick

Pool Wildcat



Date Comm. 5-18-56 MAY 29 1956

8" @ 80/70 drlc. 2354 MAY 29 '56

O&A

Co.

Loc.

No.

Sec.

T.

R

County Cowley Elev. \_\_\_\_\_  
 Sec. 17 Twp. 33 Rge. 6E  
 Company Line Petroleum  
 Farm Name Lamb No. 1

TOPS	DEPTH	LOG	DATUM	Loc. in Sec.						
Anh.				SW NW SE						
Tp.										
H.										
Tr.										
Dg.										
Bl.										
L.				Geol. _____						
K.C.				Contr. _____						
B.K.C.				Kirkpatrick						
Ce.										
C.				Pool						
M.										
M.				Wildcat						
K.										
Mz.				<table border="1"> <tr> <td colspan="2" style="text-align: center;"><u>1/4 mile</u></td> </tr> <tr> <td colspan="2" style="text-align: center;">FIRST REPORT</td> </tr> <tr> <td colspan="2" style="text-align: center;">MAY 23 '58</td> </tr> </table>	<u>1/4 mile</u>		FIRST REPORT		MAY 23 '58	
<u>1/4 mile</u>										
FIRST REPORT										
MAY 23 '58										
Me.										
V.										
S.										
S.										
A.										
R.										
PE.										
G.										
T.D.										

Date Comm. 5-18-56  
8" @ 80/70 drlg. 2354

COPY C.S. VAN  
M.M.