


Section 18 Township 33 Range 6E

Well No. 1 Coggins

Company Fortier & Wright

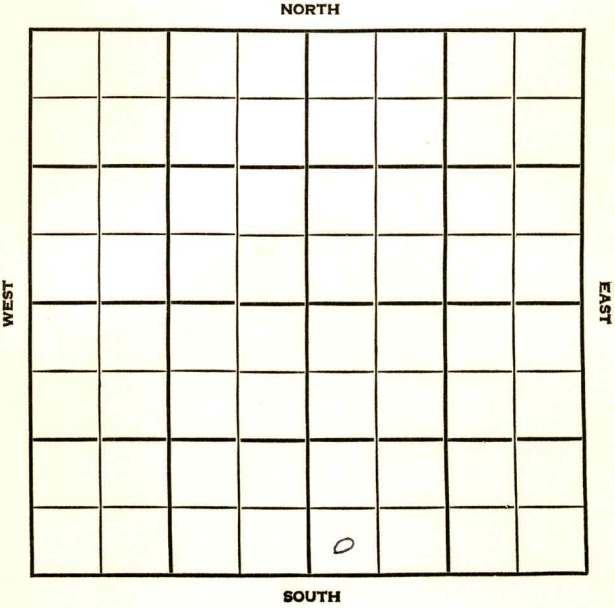

Cowley

KANSAS

SEC.	TWP.	R.
18	33	6E

WELL NO.

#1 Coggins

FARM

COMPANY

Fortier & Wright

CONTRACTOR

Cabin Valley Pool

NORTH

Ft. from N. Line

330 Ft. from S. Line

Ft. from E. Line

330 Ft. from W. Line

WEST

EAST

SOUTH

SW SW SE

1/2 mile Sunray

1955

ELEVATION

1303'

REPORT

4/27

Location

5/26

Stal 1858; Lay 2288; Congl 3069;
Miss 3084;
TD 3134; 8th 87; log; no BTV D&A

~~FIRST REPORT~~

+

ABANDONED

ABANDONED

County Cowley Elev. 1303Sec. 18 Twp. 33 Rge. 6ECompany Fortier & WrightFarm Name Coggins No. 1

TOPS

DEPTH

DATUM

Cim. Anhydrite

Ft. Riley

Howard Stal. 1858 555Topeka Lay 2288 985

Heebner Sh.

Toronto Ls.

Brown Lime

Lansing

Kans. City

B. K. C.

Congl. 3069 1766

Miss. 3084 1781

Kinderhook

Misener

Hunton

Sylv. Maquo

Viola

Simpson

Smp.

Gorham

Arbuckle

Basal Sand

Pre. Cam.


T. D. 3134

Loc. in Section

SW SW SE

Drlg. Contr. Co. tools

Pool

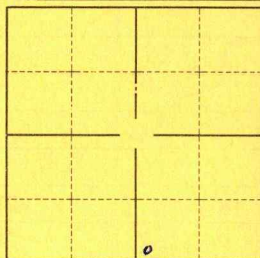

Date Comm.

Date Comp. MAY 25 '55

Spud 5-5-55 8" @ 87 w/ 70

D & A