


Section 18 Township 33 Range 7E

Well No. #1 Ratcliff

Company Crest Pet.

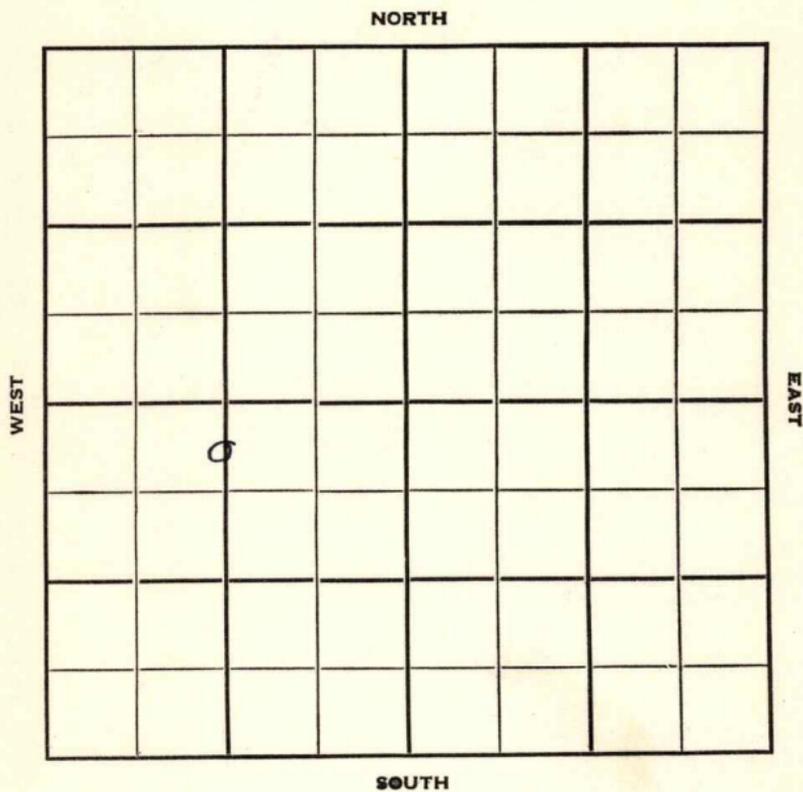

Cowley

KANSAS

Sec. 18 Twp. 33 R. 7E

Well No. #1 Ratcliff Farm

Crest Pet. Company

Contractor


330' Ft. from N. Line

..... Ft. from S. Line

..... Ft. from E. Line

1320' Ft. from W. Line

N/2 N/2 SW

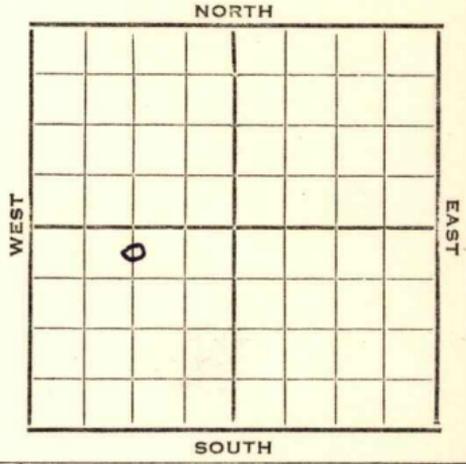

1952

Elev. 1298'

REPORT

3/26

Cellar & Pits

4/23

Spud 4-1-52

Oil Well TD 2930'

Miss. 2833' TD 2925

5" @ 2925 DD 2930 PB 2909

58/ 2867-85

Comp. 25 bopd $1\frac{1}{2}$ bw

COMPLETED

