


Section 18 Township 33 Range 13-E

Well Number 1 Lambe

Company Scott et al

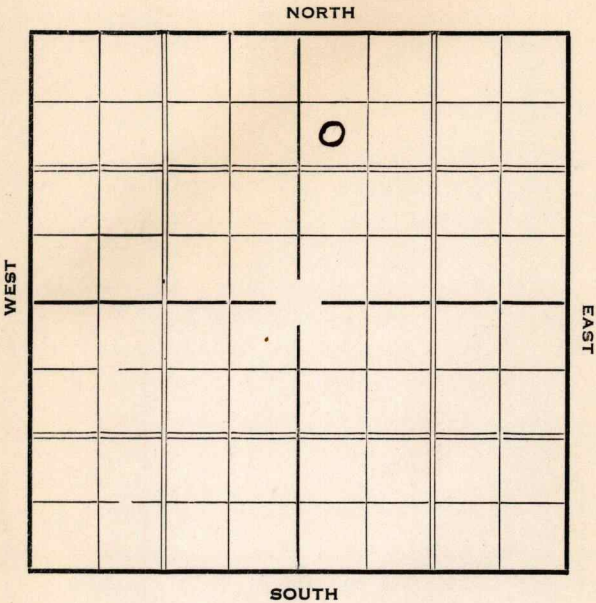

KANSAS

Chautauqua

Map No. 5 Sec. 18 Twp. 33 R. 13EWell No. 1 Lamb.Scott & Co. Company

Contractor

SECTION PLAT

		o	

990 Ft. from N. Line

_____ Ft. from S. Line

_____ Ft. from E. Line

330 Ft. from W. Line

FIRST REPORT

Location _____

Rig up _____

Drilling and Remarks:

*Back rigging
up.*

RECORD

Cased _____ in., _____ ft.

Sand _____

Gas _____

Oil _____

Total Depth _____

PRODUCTION

1st 24 hrs. Nat. _____

1st 24 hrs. after shot _____

Gas _____ Cu. Ft.

Dry Hole _____

Abandoned _____

Date

MAR 17 1937

19

S. J. LEWIS

Scout

Chart.

KANSAS

Map No. No Map Sec. 18 Twp. 33 R. 13 EWell No. 1 - LambeScott et al

Company

Contractor

ABANDONED

SECTION PLAT

		0	

990 Ft. from N. Line

_____ Ft. from S. Line

_____ Ft. from E. Line

330 Ft. from W. Line

Location _____

Rig up _____

Drilling and Remarks:

D & A

RECORD

Cased _____ in., _____ ft.

Sand Miss - 1687~~Gas~~ Sil 2000

Oil _____

Total Depth 2006

PRODUCTION

1st 24 hrs. Nat. _____

1st 24 hrs. after shot _____

Gas _____ Cu. Ft.

Dry Hole _____

Abandoned _____

Date

JUN 2 1937 19

H. D. Hatfield Scout