


Map No. KANSAS Sec. 19 Twp. 33 R. 6E

Well No. 1-Dorris Farm Ben Grallup Company

NORTH

WEST

EAST

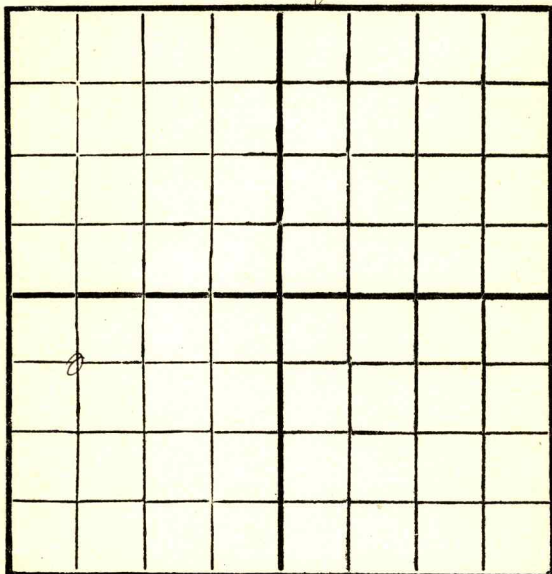

SOUTH

Location _____

Drilling Remarks _____

RECORD

Cased _____ in. _____ ft.

Sand _____

Gas _____

Oil _____

Total Depth _____

Rig Up _____

Drilling Remarks _____

PRODUCTION

1st 24 hrs. Nat. _____

1st 24 hrs. after shot _____

Gas _____ cu. ft. _____

Dry Hole _____

Abandoned _____

Cowley

Map No. **KANSAS** Sec. 19 Twp. 33 R. 6 ^EWell No. 1 Jamies
Ben Gallup Company

Contractor

FIRST REPORTS660 Ft. from N. Line

Ft. from S. Line

Ft. from E. Line

660 Ft. from W. Line**SECTION PLAT**

o			

Location

Rig up Machine

Drilling and Remarks:

RECORD

Cased _____ in., _____ ft.

Sand _____

Gas _____

Oil _____

Total Depth _____

PRODUCTION

1st 24 hrs. Nat. _____

1st 24 hrs. after shot _____

Gas _____ Cu. Ft.

Dry Hole _____

Abandoned _____

Date

OCT 1 1930

192

CHAS. L. SHERWOOD

Scout

2
 Map No. _____ Sec. 19 Twp. 33 R. 6

Well No. 1 Janis

Ben Grallup Company

Contractor

COMPLETE

660 Ft. from N. Line

_____ Ft. from S. Line

_____ Ft. from E. Line

660 Ft. from W. Line

SECTION PLAT

o			

ABANDONED

Location _____

Rig up _____

Drilling and Remarks:

RECORD

Cased _____ in., _____ ft.

Sand 608-623 Dry

Gas _____

Oil _____

Total Depth 70.3

PRODUCTION

1st 24 hrs. Nat. _____

1st 24 hrs. after shot _____

Gas _____ Cu. Ft.

Dry Hole ☒

Abandoned ☒

Date

OCT 8 1930 **CHAS. L. SHERWOOD**

192

Scout