

KANSAS

Cowley




FORM 51 5M PETROL

Section 19 Township 33 Range 8-E

Well No. #2 Polson

Company Northern Ordnance

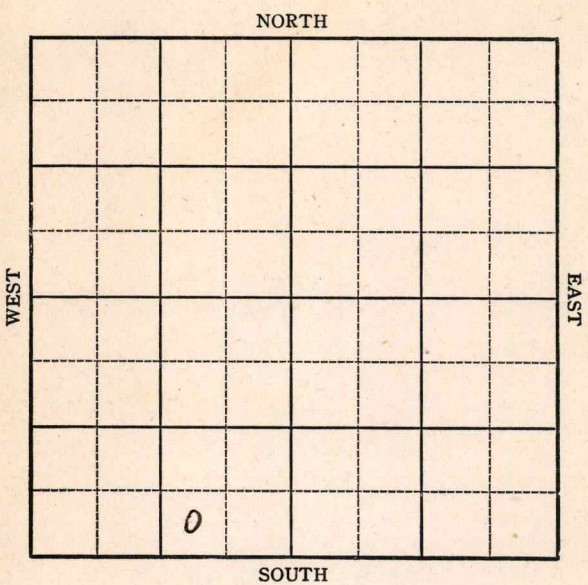

KANSAS

Map No. 3 Sec. 19 Twp. 33 R. 8E

Well No. 2 Polson

Northern Ordnance Company

ABANDONED

Contractor

SW SE SW

SECTION PLAT

_____ Ft. from N. Line

330 Ft. from S. Line

990 Ft. from E. Line

_____ Ft. from W. Line

Miscellaneous

Location _____

Rig up _____

Drilling and Remarks:

Miss 2716

RECORD

Cased _____ in., _____ ft.

Sand _____

Gas _____

Oil _____

Total Depth 2756

PRODUCTION

1st 24 hrs. Nat. _____

1st 24 hrs. after shot _____

Gas _____ Cu. Ft.

Dry Hole _____

Abandoned _____

Date

SEP 29 1943 19

S. J. LEWIS Scout

Map No. **KANSAS** 3 Sec. 19 Twp. 33 R. 8E

Well No. 2 Polson

Northern Ordnance Company

FIRST REPORT

Contractor

SW SE SW

Ft. from N. Line

330

Ft. from S. Line

990

Ft. from E. Line

Ft. from W. Line

SECTION PLAT

Miscellaneous

Location

Rig up

Drilling and Remarks:

Rotary

RECORD

Cased _____ in., _____ ft.

Sand _____

Gas _____

Oil _____

Total Depth _____

PRODUCTION

1st 24 hrs. Nat. _____

1st 24 hrs. after shot _____

Gas _____ Cu. Ft.

Dry Hole _____

Abandoned _____

Date

SEP 1 1943 19

S. J. LEWIS Scout