

SECURE X BRANCH

Ande

NEW ACO-1 FORM

SIDE ONE

STATE CORPORATION COMMISSION OF KANSAS
OIL & GAS CONSERVATION DIVISION

WELL COMPLETION OR RECOMPLETION FORM ACO-1 WELL HISTORY

DESCRIPTION OF WELL AND LEASE

Operator: license # 6723
name Camio Oil Company
address 16046 E. Harry

City State Zip Wichita, Kansas 67230

Operator Contact Person Don Baker
Phone 733-5141 (H) 733-1359 (B)

Contractor: license # 5108
name McAllister Drilling

Wellsite Geologist Joe M. Baker
Phone 733-4729

PURCHASER N/A

Designate Type of Completion
New Well Re-Entry Workover

Oil SWD Temp Abd
Gas Inj Delayed Comp.
 Dry Other (Core, Water Supply etc.)

If **OWWO**: old well info as follows:
Operator
Well Name
Comp. Date Old Total Depth

WELL HISTORY

Drilling Method: Mud Rotary Air Rotary Cable

10-27-84 11-04-84
Spud Date Date Reached TD Completion Date

38'
Total Depth PBDT

Amount of Surface Pipe Set and Cemented at 254' feet

Multiple Stage Cementing Collar Used? Yes No

If Yes, Show Depth Set feet

If alternate 2 completion, cement circulated
from feet depth to w/ SX cmt

API NO. 15- -191-21,750

County Sumner

SW SE SW Sec 4 Twp 33S Rge 2 **XXEAS**
(Location) West

330 Ft North from Southeast Corner of Section
3630 Ft West from Southeast Corner of Section
(Note: locate well in section plat below)

Lease Name TOTTEN Well# 1


Field Name Wildcat

Producing Formation N/A

Elevation: Ground 1127' KB 1133'

MAY 2 1985
State Geological Survey
WICHITA BRANCH

REC'D
STATE CORPORATION COMMISSION
FEB 20 1985
CONSERVATION DIVISION
WICHITA, KANSAS

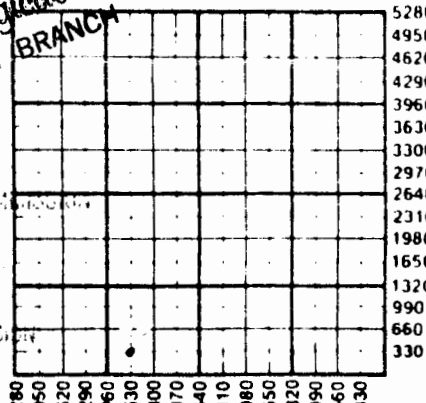

WATER SUPPLY INFORMATION

Source of Water:

Division of Water Resources Permit #

Groundwater Ft North From Southeast Corner and
(Well) Ft West From Southeast Corner of
Sec Twp Rge East West

Surface Water Ft North From Southeast Corner and
(Stream, Pond etc.) Ft West From Southeast Corner
Sec Twp Rge East West

Other (explain)
(purchased from city, R.W.D.#)

Disposition of Produced Water: Disposal
 Repressuring

Docket #

INSTRUCTIONS: This form shall be completed in duplicate and filed with the Kansas Corporation Commission, 200 Colorado Derby Building, Kansas 67202, within 90 days after completion or recompletion of any well. Rules 82-3-130 and 82-3-107 apply.
One of two of this form will be held confidential for a period of 12 months if requested in writing and submitted with the form. See rule 82-3-107 for details.
Excess of 12 months.