


Section 2 Township 33 Range 11-E

Well Number 1 Sturgis

Company Tuesday Oil.

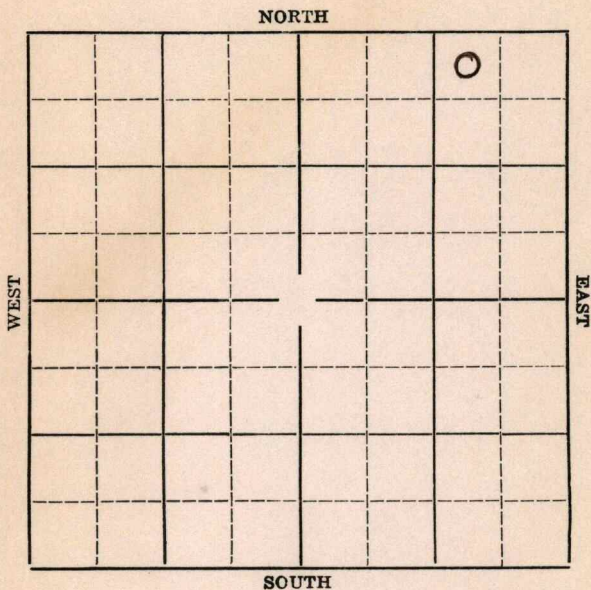

Sec. 2 Twp. 33 R. 11-E


Well No. #1 Sturgis Farm
Tuesday Oil Company

330 Ft. from N. Line

_____ Ft. from S. Line

990 Ft. from E. Line

_____ Ft. from W. Line

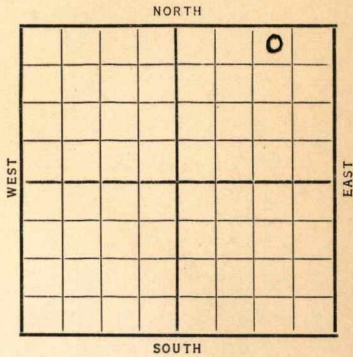

Date	REPORT
1937	
3/10	Mach.
3/18	"
3/25	"
4/2	"
4/8	"
4/16	Drlg. 280'.
4/23	" "
4/30	SD 1050'.
5/7	Peru 1140'. Oswego 1383'.
	Drlg. 1475'.
5/14	Miss. 1714'. T.D. 1770'.
	Rng. 6".
5/21	6" @ 1755'. Drlg. 1825'.
5/28	" " " " "
	- - - - -
6/2	Sil. 2038'.
	T.D. 2052'.
	H.F.W.

ABANDONED

Map No. 4 Sec. 2 Twp. 23 R. 11E

Well No. 1 Sturgis

Tuesday Oil Company _____ Contractor _____

SECTION PLAT

			0

320 Ft. from N. Line

_____ Ft. from S. Line

990 Ft. from E. Line

_____ Ft. from W. Line

FIRST REPORT

Location _____

Rig up _____

Drilling and Remarks:

Mack

RECORD

Cased _____ in., _____ ft.

Sand _____

Gas _____

Oil _____

Total Depth _____

PRODUCTION

1st 24 hrs. Nat. _____

1st 24 hrs. after shot _____

Gas _____ Cu. Ft.

Dry Hole _____

Abandoned _____

Date

MAR 10 1937

19

S. J. LEWIS Scout

Chart

KANSAS

Map No. 4 Sec. 2 Twp. 33 R. 11 E

Well No. 1 - Sturges

Tuesday Oil Company

Contractor

ABANDONED

SECTION PLAT

			0

330 Ft. from N. Line

_____ Ft. from S. Line

990 Ft. from E. Line

_____ Ft. from W. Line

Location _____

Rig up _____

Drilling and Remarks:

H.F.W.

D+A

RECORD

Cased _____ in., _____ ft.

~~Sand~~ Sil. - 2038

Gas _____

Oil _____

Total Depth 2052

PRODUCTION

1st 24 hrs. Nat. _____

1st 24 hrs. after shot _____

Gas _____ Cu. Ft.

Dry Hole _____

Abandoned _____

Date

JUN 2 1937 19

H. D. Hatfield

Scout