


Section 20 Township 33 Range 5-E

Well No. #1 Stout

Company Zephyr Drilling

Miscellaneous

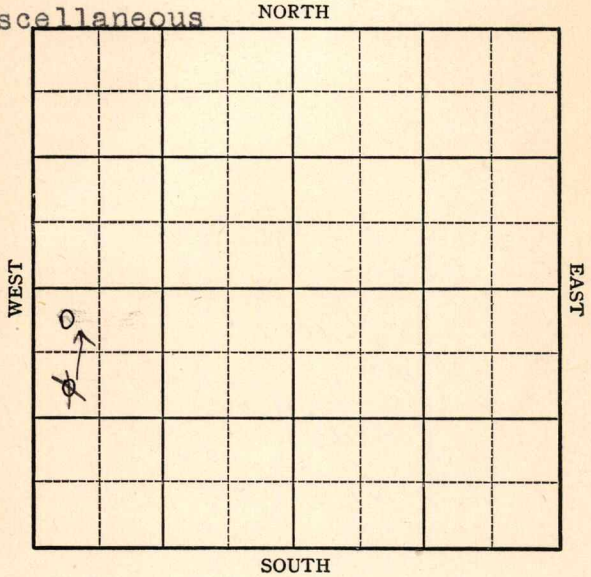

Sec. 20 Twp. 33 R. 5-E

Well No. #1 Stout Farm _____

Zephyr Drilling Company
(Miscellaneous)


330 Ft. from N. Line

_____ Ft. from S. Line

_____ Ft. from E. Line

330 Ft. from W. Line

Elev. 1190

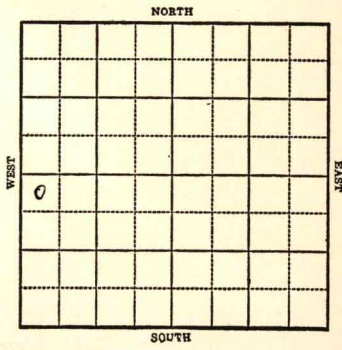

1942

R E P O R T

- 10/7 Location
- 10/14 8" @ 84 Drlg. 556'
- 10/21 **Topeka 1240**
Sand 2408
KC 2550
Ft Scott 2784
B Ft Scott 2900
Drlg 2915'
- 10/28 **Bart 3093 Nowhows**
Miss 3156
T.D. 3380
SD for water
- 11/11 **Arb. 3596**
T.D. 3619'
No shows.

ABANDONED

Cowley

Map No. 2 Sec. 20 Twp. 33 R. 5E

Well No. 1 Stout

Zephyr Drilling Company

FIRST REPORT Contractor

NW SW

SECTION PLAT

330 Ft. from N. Line

_____ Ft. from S. Line

_____ Ft. from E. Line

330 Ft. from W. Line

o			

MISCELLANEOUS

Location XXX

Rig up _____

Drilling and Remarks:

RECORD

Cased _____ in., _____ ft.

Sand _____

Gas _____

Oil _____

Total Depth _____

PRODUCTION

1st 24 hrs. Nat. _____

1st 24 hrs. after shot _____

Gas _____ Cu. Ft.

Dry Hole _____

Abandoned _____

Date

OCT 7 1942 19

S. J. LEWIS Scout

KANSAS

Map No. 2 Sec. 20 Twp. 33 R. 5E

Well No. 1 Stout

Zephyr Drilling Company

ABANDONED Contractor

NW SW

330 Ft. from N. Line

_____ Ft. from S. Line

_____ Ft. from E. Line

330 Ft. from W. Line

SECTION PLAT

o			

MISCELLANEOUS

Location _____

Rig up _____

Drilling and Remarks:

Cor X 3596

Noe hws

RECORD

Cased _____ in., _____ ft.

Sand _____

Gas _____

Oil _____

Total Depth 8619

PRODUCTION

1st 24 hrs. Nat. _____

1st 24 hrs. after shot _____

Gas _____ Cu. Ft.

Dry Hole _____

Abandoned _____

Date

NOV 11 1942

19

S. J. LEWIS

Scout