

O.W.W.O.

Cowley


KANSAS

SECTION 21 TOWNSHIP 33 RANGE 4E

WELL NO. #2 Collinson

COMPANY ~~Bob Jones~~ C-K-S-Management

NORTH

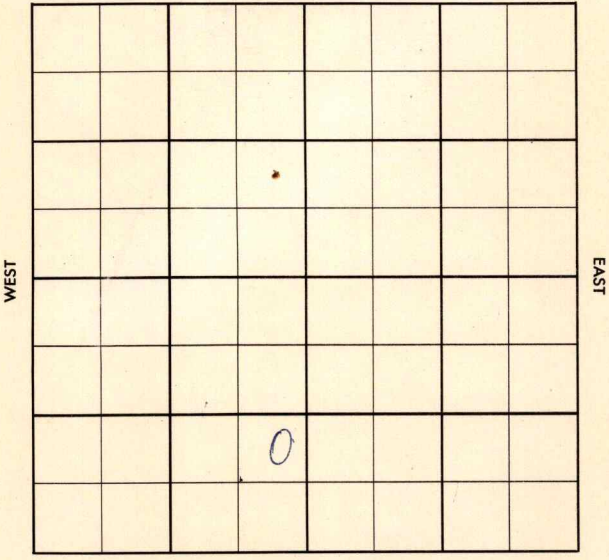

SOUTH

County Cowley Elev. \_\_\_\_\_  
 Sec. 21 Twp. 33 Rgs. 4E  
 Company Bob Jones  
 Farm Name Collinson No. 2

TOPS	DEPTH	LOG	DATUM
Anh.			
Tp.			
H.			
Tr.			
Dg.			
Bl.			
L.			
K.C.			
B.K.C.			
Ce.			
C.			
M.			
M.			
K.			
Mz.			
Me.			
V.			
S.			
S.			
A.			
R.			
Pe.			
G.			
T.D.			

Loc. in Sec. NE SE SW

Geol. \_\_\_\_\_  
 Contr. Kriswell Drlg.

Pool Posey

	0	

Date Comm. 10-5-56

FIRST REPORT

8" @ 80 w/125, Drlg. 1760 OCT 10 '56

OCT 14 1956

*[Handwritten signature]*

R. G.

Co.  
No.  
Sec.  
T.  
R.

~~28~~  
O.W.W.O.

S-513-A

CO. Cowley ELEV. 1151  
SEC. 21 TWP. 33 RGE. 4E  
COMPANY Bob Jones NO. 2

FIRST REPORT		
DEC 18 57		

FARM Collinson

LOC. NE SE SW OWWO O.W.W.O.

Stal. 2032
Lay. 2457
KC 2615
Clev. 2748
Osw. 2812
Peru 2923
Miss. 3148

GEOL. \_\_\_\_\_  
 CONTR. \_\_\_\_\_  
 POOL Posey  
 SPUD \_\_\_\_\_  
OTD 3158 PB 2830  
 40/ 2751-61 S/ 3 boph  
 frac F/ 140 bo 1 hr.

CO. T

LSE.

NO.

SEC.

TWP.

RGE.

County Cowley Elev. 1151  
 Sec. 21 Twp. 33 Rgs. 4E  
 Company Bob Jones  
 Farm Name Collinson No. 2

TOPS	DEPTH	LOG	DATUM	Loc. in Sec.
Anh.				NE-SE SW
Tp. <u>Stall</u>		<u>2032</u>		
H. <u>Lay</u>		<u>2457</u>		
Tr.				
Dg.				
Bl.				
L.				
K.C.		<u>2615</u>		Geol.
<u>Clay</u>		<u>2748</u>		Contr.
Co. <u>asw</u>		<u>2812</u>		Kriswell Drlg
Cr. <u>Peru</u>		<u>2923</u>		
M. <u>chat</u>		<u>3148</u>		Pool
M.				Posey
K.				
Mz.				
Mo.				
V.				
S.				
S.				
A.				
R.				
PE.				
G.				
TD.	<u>3158</u>			

COMPLETE  
 NOV 15 '56

Date Comm. 10-5-56

8" @ 80 w/125, Drlg. 1760 OCT 17 '56 4 1/2 @

3153/125 OCT 24 CO. 3158 DD3163

50+wt Frac @ 6 Bot + 14

Bwph decreased to 3 Bot +

8 Bwph in 16 hrs POP OCT 31 '56 ✓

NOV 7 '56 ✓ NOV 13 '56 P. 58 Bot + Tr.

wt P. 25 Bopd + Tr wt.

~~O.W.W.O.~~

~~COMPLETION~~

COMPLETE

CO. Cowley ELEV. 1151  
SEC. 21 TWP. 33 RGE. 4E  
COMPANY Bob Jones NO. 2

MAR 12 '58

C-K-S-Management

FARM Collinson

LOC. NE SE SW O.W.W.O.

Stal. 2032
Lay. 2457
KC 2615
Clev. 2748
Osw. 2812
Peru 2923
Miss. 3148
TD3164

GEOL. \_\_\_\_\_  
 CONTR. O.W.W.O.  
 POOL Posey  
 SPUD \_\_\_\_\_  
OTD 3158 PB 2830  
40/ 2751-61 S/ 3 boph  
frac F/ 140 bo 1 hr.  
DEC 26 '57 F10 200 BO  
35 minutes @  
41°

wopot JAN 15 '58 JAN 22 '58 DD 3164TD  
F10 50 BO each day 4 hrs  
gr 43° thru CSG NW  
 JAN 29 '58 FEB 5 '58 5" FEB 12 '58  
wop  
 FEB 19 '58 26 '58 MAR 5 '58 MAR 12 '58 Tbg  
F10 100 BO 45" 7/64" chh  
F10 15 BO pd NW

CO.  
LSE.  
NO.  
SEC.  
TWP.  
RGE.