


O.I.W.O.

Section 21 Township 33 Range 1E

Well No. ~~#1 Coulson~~ #2 Collinson

Company ~~McNish & Grallpp~~ Bob Jones

NORTH

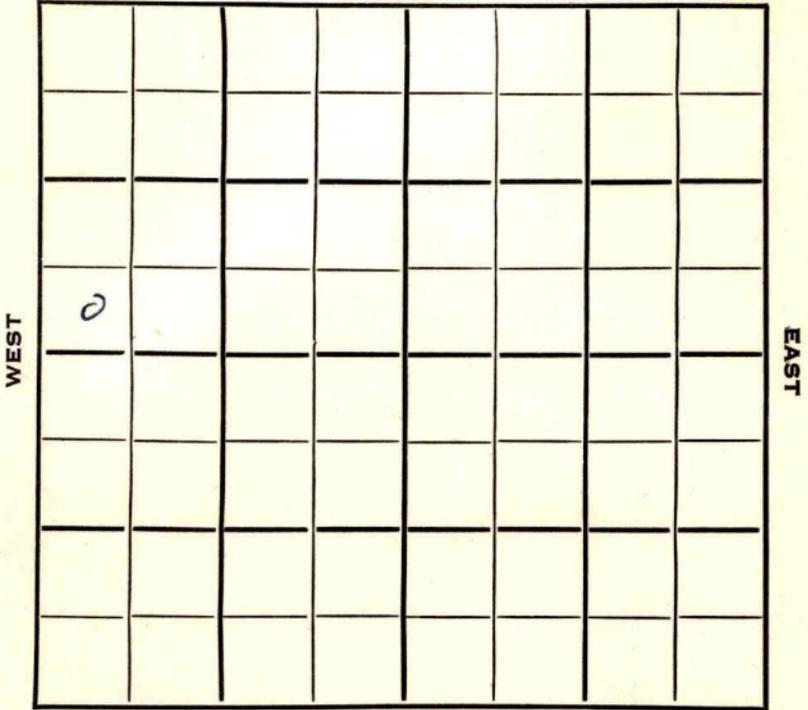

SOUTH

WEST

EAST

O.W.W.O. Cowley

Sec. 21 Twp. 33 R. 4E

Well No. #1 Coulson #2 *Collinson* Farm

~~McNish & Grallop~~ *Bob Jones* Company

Watson Drlg. Contractor
Wildcat


Ft. from N. Line

330 Ft. from S. Line

Ft. from E. Line

330 Ft. from W. Line

SW SW NW

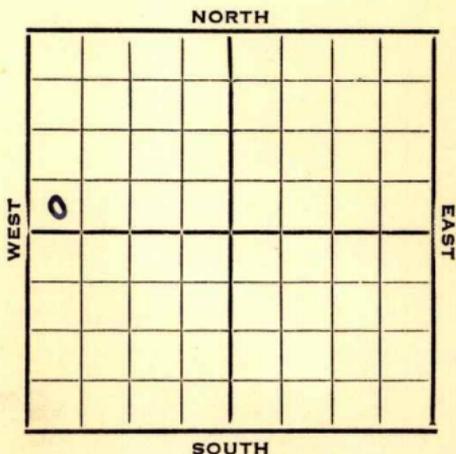

1953 Elev. 1153' REPORT

2/4 Spud 1-31-53
8" @ 90
Drlg. 750'

2/18 Spud 1-31-53 D & A TD 3193
8" @ 90 Layton 2475 Bart 3153
TD 3193' D & A

ABANDONED

1956

O.W.W.O.

5-2 OTD 3193
5" @ 3187
CO

5-9 CO 3193
FU 7 go / 5 gw, 12 hrs., frac
~~XXXXXXXX~~ lost load.
D&A

Lay. 2475', Bartl. 3153, M. 3183',
TD ~~3193~~ 3193'

ABANDONED

~~COMPLETED~~

OWMO

County Cowley Elev. _____
 Sec. 21 Twp. 33 Rge. LE
 Company Bob Jones
 Farm Name Collinson No. 2

TOPS	DEPTH	LOG	DATUM	Loc. in Sec.
Anh.				SW SW NW
Fp. <u>624</u>	<u>2475</u>			
H.				
Tr. <u>Bartl</u>	<u>3153</u>			
Dg.				
Bl.				
L.				Geol. _____
K.C.				Contr. _____
B.M.C.				<u>McNeish & Co</u>
Ce.				
C.				
M.	<u>3183</u>			Pool _____
M.				<u>Posey</u>
K.				
Mz.				
Mo.				
V.				
S.				
S.				
A.				
R.				
PE.				
G.				
TD.	<u>3193</u>			

ABANDONED

Date Comm. MAY 9 1956
OTD 3193 5" @ 3187 CO MAY 9 '56 CO
3193 FU 7 90 + 5 9w 12 hrs
Frac Lost Ld.

DEA


County Cowley State Kansas

Sec. 21 (Blk. 33) (Sur. 4E) (Rge.) Map No.

Operator McNish & Grallop

Well No. 1 Farm Coulson

Elev. 1153 Location SW SW NW

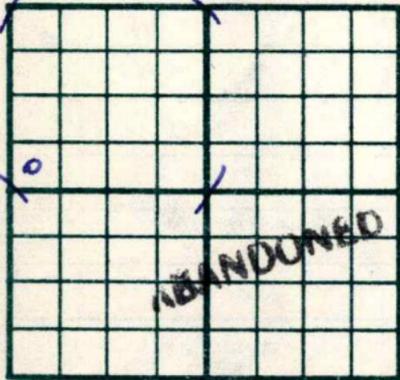

330 Ft. From S Line NW

330 Ft. From W Line Quarter

1st. Report

FEB 18 1953

Completion

Remarks Wildcat

Watson Drlg. - Contr.

Spudding Date 1-31-53

Drlg. Data D & A TD 3193

8" @ 90 Layton 2475 Bart. 3153 TD 3193

D & A

~~O.W.W.O.~~

~~OWHO~~

County Cowley Elev. _____
 Sec. 21 Twp. 33 Rge. 4E
 Company Bob Jones
 Farm Name Collinson No. 2

TOPS	DEPTH	LOG	DATUM
Anh.			
TP.			
H.			
Tr.			
Dg.			
BL.			
L.			
K.C.			
B.K.C.			
Ce.			
C.			
M.			
M.			
K.			
Mz.			
Me.			
V.			
S.			
S.			
A.			
R.			
Pe.			
G.			
T.D.			

Loc. in Sec. SW SW NW

Geol. _____

Contr. McNeish & Graf

Pool Posey

FIRST REPORT
MAY 2 '56

Date Comm. OTD 3193 5" @ 3187 CO

~~MAY 1 @ 1956~~

~~209~~

Co.
No.
Sec.
T.
R.