


Cowley

KANSAS

SECTION 22 TOWNSHIP 33 RANGE 4E

WELL NO. #2 Walters

COMPANY McNeish etal

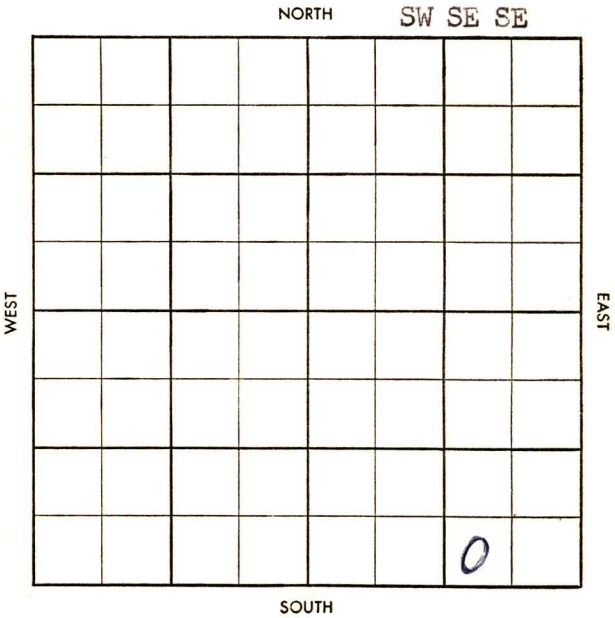

~~29~~

5-513-A

CO. ~~Cowley~~ ELEV. _____

SEC. 22 TWP. 33 RGE. 4E

COMPANY McNeish etal NO. 2

FIRST REPORT			
OCT 23 '37			

FARM Walters

LOC. SW SE SE

GEOL. _____

CONTR. Watson tools

POOL Seacat

SPUD _____

RURT _____

CO.

LSE.

NO.

SEC.

TWP.

RGE.

