

Cowley


DX 78-1

KANSAS

Section 24 Township 33 Range 6E

Well No. #1 Leith

Company Ayesh Oil

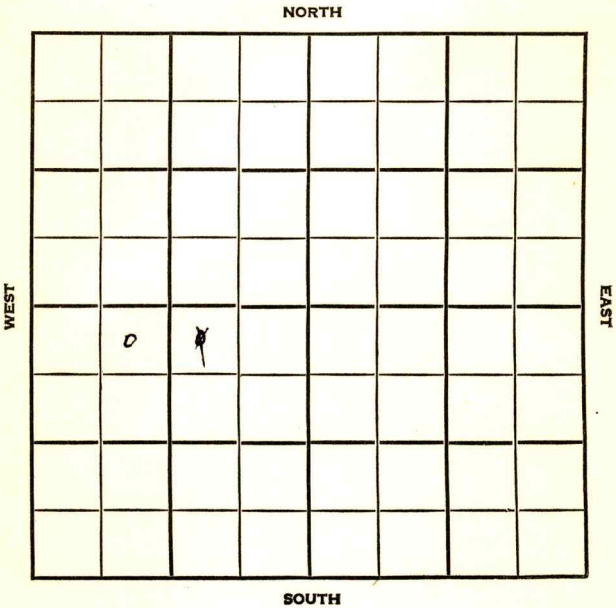

Cowley

KANSAS

SEC.	TWP.	R.
24	33	6E

WELL NO.

#1 Leith

FARM

COMPANY

Ayesh Oil

CONTRACTOR

Kriesswell Drlg.

Dexter Pool

330

Ft. from N. Line


Ft. from S. Line

~~990~~

Ft. from E. Line

990

Ft. from W. Line

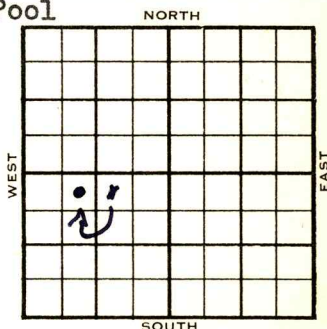

NE NW

~~NW NE~~ SW

	ELEVATION	REPORT
1954	1194'	

10/27 Spud 10-16-54
8" @ 106'
Drlg. 1000'

11/23 Spud 10-16-54
D & A
TD 2869'
8" @ 106'

Layton 1984' KC 2213' Pawnee 2390'
Oswego 2468' Cherokee 2554' Miss 2819'
TD 2869'
D & A

ABANDONED

County **Cowley** State **Kansas**

Sec. **24** (Blk. **33** (Sur. **6E** Map No.

Operator **Ayesh Oil**

Well No. **1** Farm **Leith**

Elev.	Location	NW	NE	SW
-------	----------	----	----	----

FIRST REPORT

330 Ft. From N Line SW

990 Ft. From **E** Line Quarter

1st. Report OCT 27 1954

Completion

Remarks

Krisswell D,lg. - Contr

Spudding Date **10-16-54**

Drlg. Data Dexter Pool

8" @ 106 drlg. 1000

FABEN GILSTRAP

Kansas

Map No. _____ Sec. 24 Twp. 33 R. 6EWell No. 1 LeithAyesh Oil CompanyCORRECTION Contractor


NE NW SW

SECTION PLAT

330 Ft. from N. Line

_____ Ft. from S. Line

_____ Ft. from E. Line

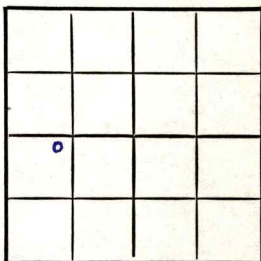990 Ft. from W. LineCowley County

Location _____

Rig up _____

Drilling and Remarks:

Reported

NW NE SW

RECORD

Cased _____ in., _____ ft.

Sand _____

Gas _____

Oil _____

Total Depth _____

PRODUCTION

1st 24 hrs. Nat. _____

1st 24 hrs. after shot _____

Gas _____ Cu. Ft.

Dry Hole _____

Abandoned _____

Date

NOV 10 1954

19

FABEN GILSTRAD Scout



(Blk.)
(Twp.)

Ayesh Oil

1 Farm Leith

1194	Location	NE	NW	SW
------	----------	----	----	----

990 Ft. From W Line Quarter

Completion NOV 23 1954

Krisswell Drlg. - Contr.

Spudding Date 10-16-54

D & A TD 2869

Pawnee 2390 Oswego 2468 Cherokee 2554

Miss. 2819 TD 2869

D & A

FABEN GILSTRAP