


Well No. 1-9 Stevens Farm
Ben Grallus et al Company

NORTH

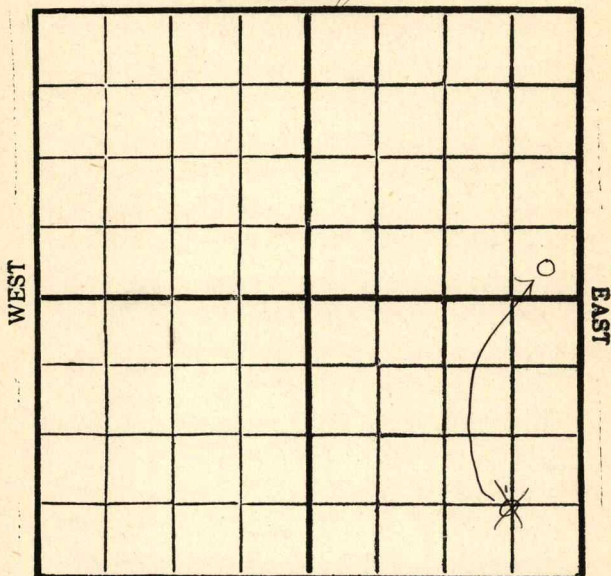

SOUTH

Rig Up _____

Drilling Remarks

[illegible][illegible]

RECORD

Cased _____ in. _____ ft.

Sand _____

Gas_____

Oil _____

Total Depth_____

PRODUCTION

1st 24 hrs. Nat. _____

1st 24 hrs. after shot_____

Gas_____cu. ft._____

Dry Hole_____

Abandoned _____

2 **KANSAS** Sec. 24 Twp. 33 R. 5

Well No. 1 Stevens

Ben Grallup et al Company

Contractor

COMPLETE

SECTION PLAT

			0

 Ft. from N. Line

250 Ft. from S. Line

250 Ft. from E. Line

 Ft. from W. Line

Location

Rig up

Drilling and Remarks:

RECORD

Cased in., ft.

Sand 583-604

Gas

Oil

Total Depth 604

PRODUCTION

1st 24 hrs. Nat.

1st 24 hrs. after shot

Gas 1 M Cu. Ft.

Dry Hole

Abandoned

Date

OCT 2 2 1930

19

CHAS. L. SHERWOOD

Scout

2

KANSAS

Cowley

Map No. _____ Sec. 24 Twp. 33 R. 5^EWell No. 1 StevensBen Grallup et al Company

Contractor _____

FIRST REPORTS**SECTION PLAT**

_____ Ft. from N. Line

660 Ft. from S. Line660 Ft. from E. Line

_____ Ft. from W. Line

			0

Location _____

RECORDRig up Machine

Cased _____ in., _____ ft.

Sand _____

Gas _____

Oil _____

Total Depth _____

Drilling and Remarks:

PRODUCTION

1st 24 hrs. Nat. _____

1st 24 hrs. after shot _____

Gas _____ Cu. Ft.

Dry Hole _____

Abandoned _____

Date

OCT 8 1930

CHAS. L. SHERWOOD

Cowley
 2 **KANSAS**
 Map No. _____ Sec. *24* Twp. *33* R. *5*^E

Well No. *1* *Stevens*

Ben Gallup et al Company

Contractor

CORRECTION

SECTION PLAT

			<i>2</i>
			<i>0</i>

_____ Ft. from N. Line

750 Ft. from S. Line

750 Ft. from E. Line

_____ Ft. from W. Line

Location _____

Rig up _____

Drilling and Remarks:

chg location

RECORD

Cased _____ in., _____ ft.

Sand _____

Gas _____

Oil _____

Total Depth _____

PRODUCTION

1st 24 hrs. Nat. _____

1st 24 hrs. after shot _____

Gas _____ Cu. Ft.

Dry Hole _____

Abandoned _____

Date

OCT 15 1930

19

CHAS. L. SHERWOOD

Scout