

**KANSAS**

Cowley


Section 27 Township 33 Range 6E

Well No. #1 Fry

Company Deep Rock

Miscellaneous

NORTH

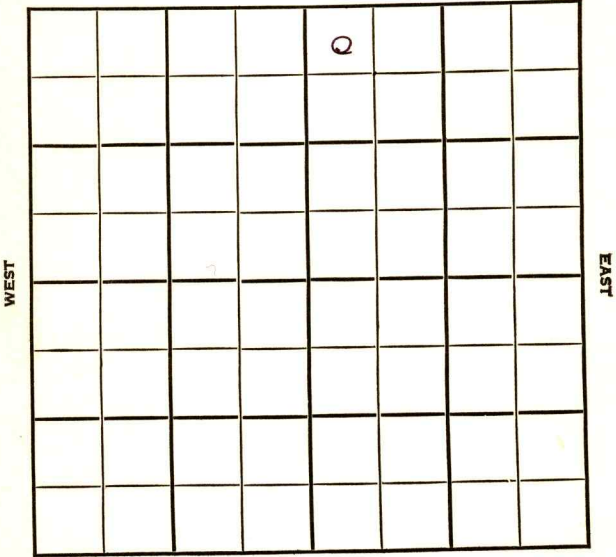

SOUTH



Sec. 27 Twp. 33 R. 6E

Well No. #1 Fry Farm \_\_\_\_\_

Deep Rook Company \_\_\_\_\_


Misc. \_\_\_\_\_

330 Ft. from N. Line

\_\_\_\_\_ Ft. from S. Line

\_\_\_\_\_ Ft. from E. Line

330 Ft. from W. Line

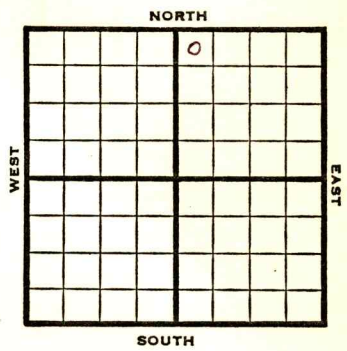

NW NE

1948

**Elev. 1149'** REPORT

4/7 Location

4/14 RUR

4/21 10" @ 125'  
Drlg. 2235'

4/28 **Miss 2935'**  
TD 2957'

**ABANDONED**

Map No. \_\_\_\_\_ Sec. 27 Twp. 33 R. 6E

Well No. 1 Fry

Deep Rock Company

FIRST REPORT Contractor

NW NE

SECTION PLAT

330 Ft. from N. Line

\_\_\_\_\_ Ft. from S. Line

\_\_\_\_\_ Ft. from E. Line

330 Ft. from W. Line

		6	

Cowley County

Location X

Rig up \_\_\_\_\_

Drilling and Remarks:

RECORD

Cased \_\_\_\_\_ in., \_\_\_\_\_ ft.

Sand \_\_\_\_\_

Gas \_\_\_\_\_

Oil \_\_\_\_\_

Total Depth \_\_\_\_\_

PRODUCTION

1st 24 hrs. Nat. \_\_\_\_\_

1st 24 hrs. after shot \_\_\_\_\_

Gas \_\_\_\_\_ Cu. Ft.

Dry Hole \_\_\_\_\_

Abandoned \_\_\_\_\_

Date

APR 7 1948 19

S. J. LEWIS Scout

Map No. 2 Sec. 27 Twp. 33 R. 6E

Well No. 1 Fry

Deep Rock Company

**ABANDONED**

Contractor

NW NE

E. 1149  
SECTION PLAT

330 Ft. from N. Line

\_\_\_\_\_ Ft. from S. Line

\_\_\_\_\_ Ft. from E. Line

330 Ft. from W. Line

		0	

Cowley County

Location \_\_\_\_\_

Rig up \_\_\_\_\_

Drilling and Remarks:

*Apr 29 1935*

RECORD

Cased \_\_\_\_\_ in., \_\_\_\_\_ ft.

Sand \_\_\_\_\_

Gas \_\_\_\_\_

Oil \_\_\_\_\_

Total Depth 2957

PRODUCTION

1st 24 hrs. Nat. \_\_\_\_\_

1st 24 hrs. after shot \_\_\_\_\_

Gas \_\_\_\_\_ Cu. Ft.

Dry Hole \_\_\_\_\_

Abandoned \_\_\_\_\_

Date

APR 28 1948 19 \_\_\_\_\_ S. J. LEWIS Scout