


SECTION 27 TOWNSHIP 33S RANGE 6E

WELL NO. #1 Fry

COMPANY Crest Petroleum

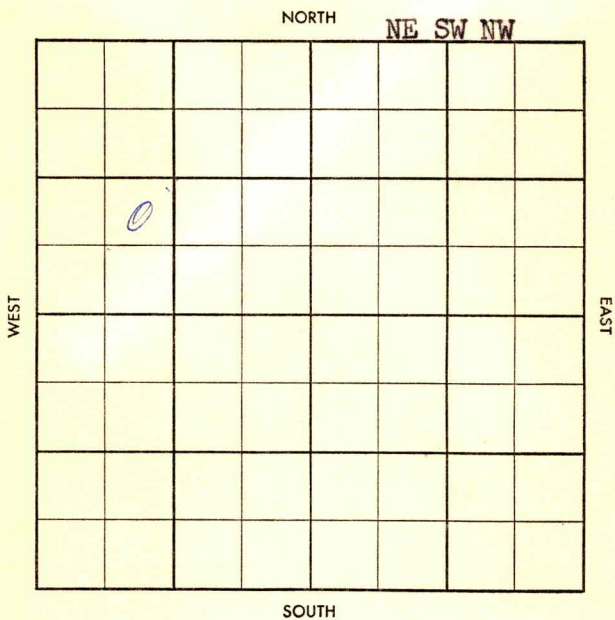

Twp. ~~X~~ Pool ~~X~~  
 Co. ~~X~~ Facet ~~X~~

S-513-B

County Cowley Elev. 11510E 11544E  
 Sec. 27 Twp. 33 Rge. 6E  
 Company Crest Petroleum  
 Farm Name Fry No. 1

TOPS	DEPTH	LOG	DATUM
<del>Loy</del>	<del>2158</del>		
Sp. 1	1730		
Loy 2	2126		
Loy 2	2156		
B.L.			
L.			
K.C.	2394		
B.K.C. <u>mark</u>	2572		
Ce.	2716		
C.			
M.	2975		
M.			
K.			
Mz.			
Mq.			
V.			
S.			
S.			
A.			
R.			
Pf.			
G.			
T.D.	2984		

Loc. in Sec. NE SW NW  
 Geol. \_\_\_\_\_  
 Contr. \_\_\_\_\_  
 Co. Tools \_\_\_\_\_  
 Pool RAIN NE

APR 23 '58  
 ABANDONED

Date Comm. 4-2-58 8" 125  
 Location APR 9 '58 0 2200 APR 15 '58 APR 23 '58

DBA

