


Section 27 Township 33 Range 6E

Well No. #4 Fry

Company Woods Drlg.

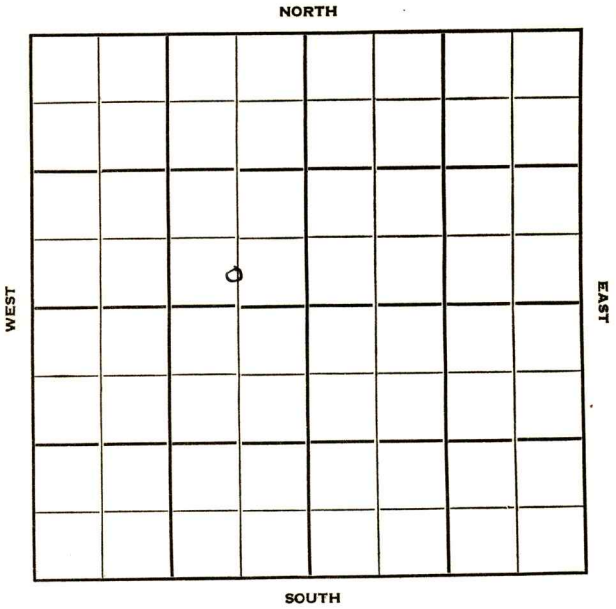

Cowley

KANSAS

Sec. 27 Twp. 33 R. 6 E ✓

Well No. # 4 Fry Farm \_\_\_\_\_

Woods Drlg. Company \_\_\_\_\_

Coppit Contractor \_\_\_\_\_


\_\_\_\_\_ Ft. from N. Line

330 Ft. from S. Line

730 Ft. from E. Line

\_\_\_\_\_ Ft. from W. Line

C S L - SE NW

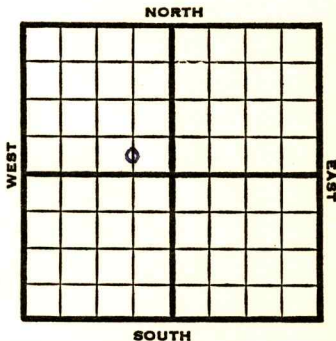

1951

Elev. 1143'

REPORT

2/21

Spud 2-18-51  
8" @65  
Drlg. 525'

3/14

Spud 2-18-51  
D & A TD 3016'  
8" @ 65 Miss. 3002'  
TD 3016' D & A

**ABANDONED**

County **Cowley** State **Kansas**

Sec. **27** (Blk. Twp.) **33** (Sur. Rge.) **6E** Map No.

Operator **Woods Drlg.**

Well No. **4** Farm **Fry**

Elev. Location **C S L SE NW**



**330** Ft. From **S** Line **NW**

**730** Ft. From **E** Line **Quarter**

1st. Report **FEB 21 1951**

Completion

Remarks

**Coppit - Contr.**

Spudding Date **2-18-51**

Drlg. Data

**8" @ 65 drlg. 525**

J. E. TYRA

County Cowley State Kansas

Sec. 27 (<sup>Bk.</sup>Twp.) 33 (<sup>Sur.</sup>Rge.) 6E Map No.

Operator Woods Drlg.

Well No. 4 Farm Fry

Elev. 1143 Location C S L SE NW



330 Ft. From S Line NW

730 Ft. From E Line Quarter

1st. Report

Completion MAR 14 1951

Remarks

Coppitt - Contr.

Spudding Date 2-18-51

Drlg. Data D & A TD 3016

8" @ 65 Miss. 3002 TD 3016

D & A

J. E. TYRA