


Section 27 Township 33 Range 6 EWell No. # 6 FryCompany Woods Drlg.

Cowley

KANSAS

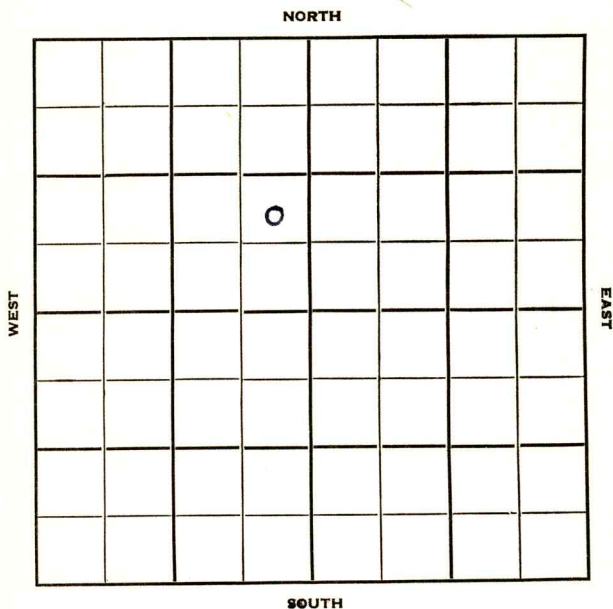

Sec. 27 Twp. 33 R. 6E

Well No. #6 Fry Farm

Woods Drlg. Company

Cappitt - Contr. Contractor


 Ft. from N. Line

800' Ft. from S. Line

330' Ft. from E. Line

 Ft. from W. Line

NE SE NW

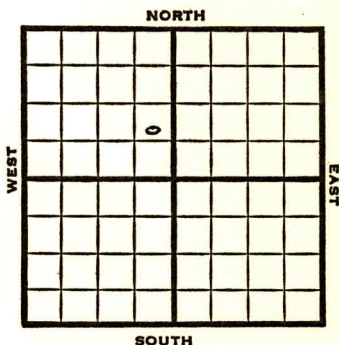

1951

Elev. 1146'

REPORT

3/21

RUR

5/2

Spud 3-19-51
Oil Well TD 2940
8" @ 65
Bart 2887
TD 2940 5" @ 2938
24/2893-99 Hydrafrac
Comp. 135 bopd

COMPLETED

County **Cowley** State **Kansas**Sec. **27** (Blk.) **33** (Sur.) **6E** Map No.Operator **Woods Drlg.**Well No. **6** Farm **Fry**Elev. Location **NE SE NW**

FIRST REPORT

800 Ft. From **S** Line **NW****330** Ft. From **E** Line Quarter1st. Report **MAR 21 1951**

Completion

Remarks


Cappitt - Contr.

Spudding Date

Drlg. Data

RUR

J. E. TYRA

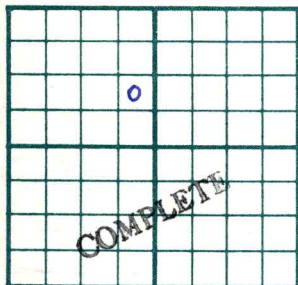County Cowley State KansasSec. 27 (Blk. Twp.) 33 (Sur. Rge.) 6E Map No.Operator Woods Drlg.Well No. 6 Farm FryElev. 1146 Location NE SE NW800 Ft. From S Line NW330 Ft. From E Line Quarter

1st. Report

Completion MAY 2 1951

Remarks

Cappitt - Contr.Spudding Date 3-19-51Drlg. Data Oil well TD 29408" @ 65 Bart. 2887 TD 2940 5" @ 293824/ 2893-99 Hydrofrac Comp. 135 bopd

J. E. TYRA