


Section 27 Township 33 Range 6 E

Well No. # 7 Fry

Company Woods Drlg.

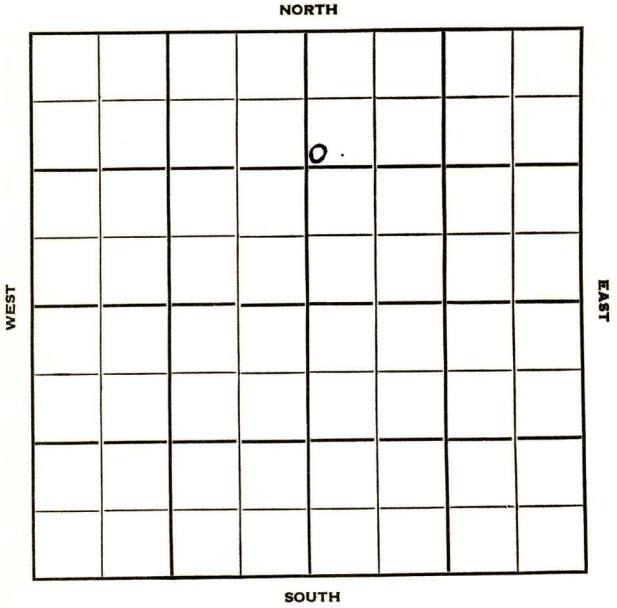

27

33

Sec. _____ Twp. _____ R. _____

Well No. #7 Fry Farm _____

Woods Drlg. Company _____

Woods Drlg. - Contr. Contractor _____


1295' Ft. from N. Line

_____ Ft. from S. Line

_____ Ft. from E. Line

2665' Ft. from W. Line

SW NW NE

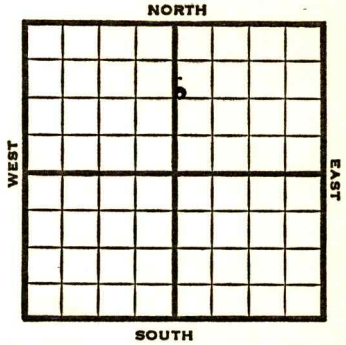

1951 **Elev. 1152'** REPORT

4/18
5/9

RUR
 Spud 4-22-51
 D&A TD 3021
 10" @ 8'

Layton 2105	KC 2275
Marmaton 2468'	Oswego 2546
Cherokee 2700	Skinner 2788
Coal 2903	Burbank 2930
Miss 3000'	TD 3021

D&A

ABANDONED

