


Cowley

KANSAS

SECTION 27 TOWNSHIP 33S RANGE 4E

WELL NO. #1 Sheehan

COMPANY Shawver-Armour

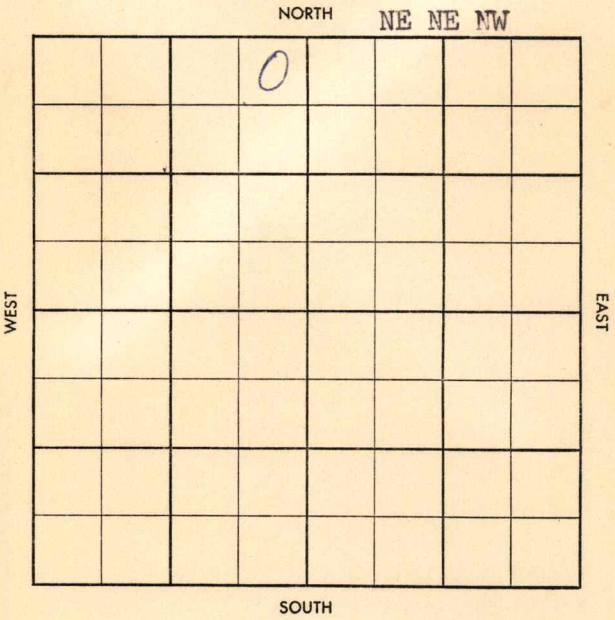

County Cowley Elev. 1116 DP 1119 RE
 Sec. 27 Twp. 33 Rge. 4E
 Company Shawver-Armour
 Farm Name Sheehan No. 1

	TOPS	DEPTH	LOG	DATUM
Anh.	<u>Loy</u>	<u>2432</u>		
Tp.				
H.				
Tr.				
Dg.				
B.L.				
L.				
K.C.		<u>2605</u>		
B.K.C.	<u>stal</u>	<u>1989</u>		
Ce.	<u>OSW</u>	<u>2785</u>		
C.	<u>BTU</u>	<u>3085</u>		
M.		<u>3124</u>		
M.				
K.				
Mz.				
Mq.				
V.				
S.				
S.				
A.				
R.				
Pf.				
G.				
T.D.		<u>3149</u>		

Loc. in Sec. NE NE NW
 Geol. _____
 Contr. _____
 Co. Tools # 1

Pool _____
Seacat
 0
 FEB 19 58
ABANDONED

Date Comm. 2/8/58
8" @ 156 w/130, Drlg. 1845. FEB 19 58

me + STS

D6A

Co.

Sec.

No.

Sec.

T.

R.

29

County Cowley Elev. _____

Sec. 27 Twp. 33 Rge. 4E

Company Shawver-Armour

Farm Name Sheehan No. 1

TOPS	DEPTH	LOG	DATUM
Anh.			
Tp.			
H.			
Tr.			
Dg.			
B.L.			
L.			
K.C.			
B.K.C.			
Ce.			
C.			
M.			
M.			
K.			
Mz.			
Mq.			
V.			
S.			
S.			
A.			
R.			
Pf.			
G.			
T.D.			

Loc. in Sec. _____

NE NE NW

Geol. _____

Contr. _____

Co. Tools # 1

Pool _____

Seacat



Date Comm. 2/8/58

8" @ 156 w/130, Drlg. 1845.

Co.

Lse.

No.

Sec.

T.

R.