


Section 28 Township 33 Range 6 E

Well No. # 1 Hammer

Company Orest Pet.

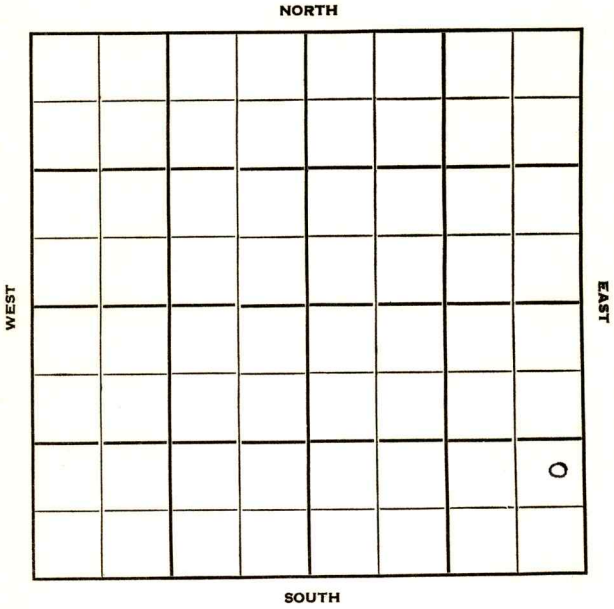

Cowley

KANSAS

Sec. 28 Twp. 33 R. 6 E ✓

Well No. # 1 Hammer Farm

Crest Pet. Company

Contractor

Semi-Wildcat


Ft. from N. Line

990 Ft. from S. Line

280 Ft. from E. Line

Ft. from W. Line

NE SE SE (Twin well)

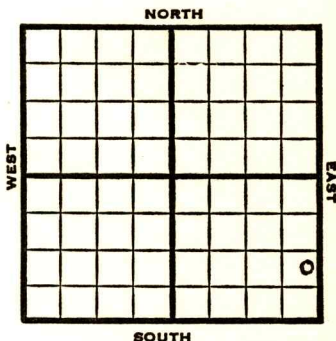

1951

REPORT

3/14

Location

4/25

D&A TD 2960

8" @ 43

**Bart 2946**

TD 2950

5" @ 2946

DD 3955

150' wtr SS0

TD 2960 wtr

D&A

**ABANDONED**



**Kansas**

Map No. \_\_\_\_\_ Sec. 28 Twp. 33 R. 6E

Well No. 1 Hammer

Crest Pet. \_\_\_\_\_ Company

~~CORRECTION~~ \_\_\_\_\_ Contractor

NE SE SE

**SECTION PLAT**

\_\_\_\_\_ Ft. from N. Line

990 Ft. from S. Line

280

330 Ft. from E. Line

\_\_\_\_\_ Ft. from W. Line

			0

Cowley County

Location \_\_\_\_\_

Rig up \_\_\_\_\_

Drilling and Remarks:

Reported

27-33-6E

**RECORD**

Cased \_\_\_\_\_ in., \_\_\_\_\_ ft.

Sand \_\_\_\_\_

Gas \_\_\_\_\_

Oil \_\_\_\_\_

Total Depth \_\_\_\_\_

**PRODUCTION**

1st 24 hrs. Nat \_\_\_\_\_

1st 24 hrs. after shot \_\_\_\_\_

Gas \_\_\_\_\_ Cu. Ft.

Dry Hole \_\_\_\_\_

Abandoned \_\_\_\_\_

Date

MAR 21 1951

19

J. E. TYRA

Scout

