

Cowley


KANSAS

SECTION 28 TOWNSHIP 33S RANGE 5E

WELL NO. #1 Bonger

COMPANY G.D. Smitherman

NORTH SE SE NW

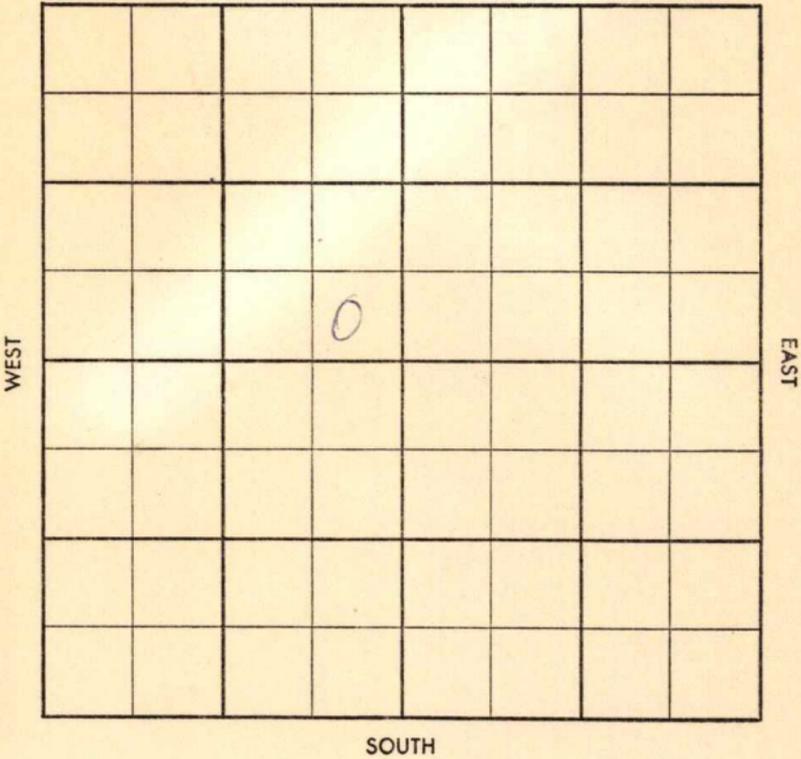

~~Twp~~ ~~Pool~~
~~Ce~~ ~~Facet~~

S-513-B

County Cowley Elev. 1242 DF 1245
 Sec. 28 Twp. 33 Rge. 5E
 Company G. D. Smitherman
 Farm Name Bonger No. 1

TOPS	DEPTH	LOG	DATUM
Anh. <u>Log</u>		<u>2387</u>	
Tp.			
H.			
Tr.			
Dg.			
B.L.			
L.			
K.C.		<u>2580</u>	
B.K.C.			
Ce.			
C.			
M.		<u>3152</u>	
M:			
K.			
Mz.			
Mq.			
V.			
S.			
S.			
A.			
R.			
Pf.			
G.			
T.D.	<u>3210</u>		

Loc. in Sec. SE SE NW
 Geol. Criswell
 Contr. Wildcat

ABANDONED
 JUN 25 '58

Date Comm. 6-13-58 (Sun - Support)
8" @ 150, Drlg. 1000 JUN 25 58 /og

D&A

Co.
 T.
 R.
 Sec.
 No.

Twp. ~~33~~ Pool ~~5E~~
WILDCAT
 00. ~~1242~~ Facet ~~DF~~

S-513-B

County Cowley Elev. 1242 DF
 Sec. 28 Twp. 33 Rge. 5E
 Company G. D. Smitherman
 Farm Name Bonger No. 1

TOPS	DEPTH	LOG	DATUM
Anh.			
Tp.			
H.			
Tr.			
Dg.			
B.L.			
L.			
K.C.			
B.K.C.			
Ce.			
C.			
M.			
M.			
K.			
Mz.			
Mq.			
V.			
S.			
S.			
A.			
R.			
Pf.			
G.			
T.D.			

Loc. in Sec. SE SE NW

Geol. _____
 Contr. Criswell

Pool Wildcat

JUN 13 1958
FIRST REPORT

Date Comm. 6-13-58 (Sun - Support)
8" @ 150, Drlg. 1000