


Cowley

KANSAS

SECTION 28 TOWNSHIP 33S RANGE 4E

WELL NO. #1 Richardson

COMPANY Albert Wilson & Smitherman

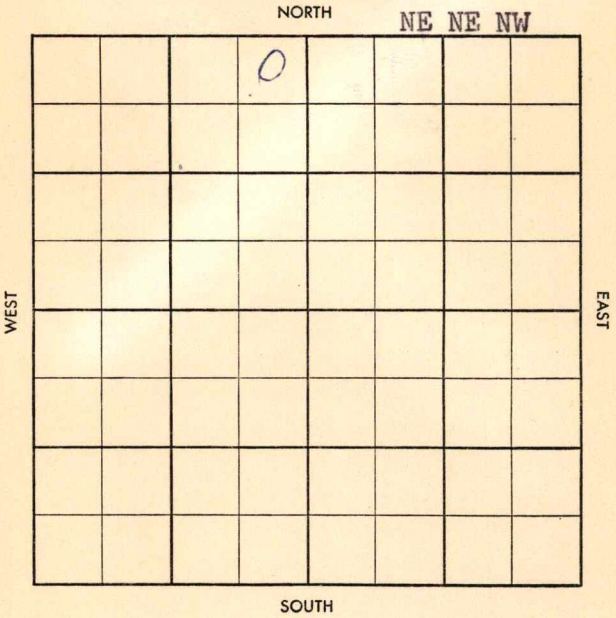

~~20~~
~~25~~
~~30~~

County Cowley Elev. _____
Sec. 28 Twp. 33 Rge. 4E
Company Albert Wilson & Smitherman
Farm Name Richardson No. 1

TOPS	DEPTH	LOG	DATUM
Anh.			
Tp.			
H.			
Tr.			
Dg.			
B.L.			
L.			
K.C.			
B.K.C.			
Ce.			
C.			
M.			
M.			
K.			
Mz.			
Mq.			
V.			
S.			
S.			
A.			
R.			
Pf.			
G.			
T.D.			

Loc. in Sec. NE NE NW
Geol. _____
Contr. Glen
Smitherman
Pool _____
Posey

APR 30 1938
FIRST REPORT

Date Comm. _____ (Sun - DHC)

Location

Twp. ~~33~~ Pool ~~X~~
 Co. ~~X~~ Facet ~~X~~

S-513-B

County Cowley Elev 11340 ~~113780~~
 Sec. 28 Twp. 33 Rge. 4E
 Company Albert Wilson & Smitherman
 Farm Name Richardson No. 1

TOPS	DEPTH	LOG	DATUM
Anh <u>Stal</u>	<u>2016</u>		
Tp. <u>Lay</u>	<u>2423</u>	<u>2423</u>	
H. <u>Clev</u>	<u>2715</u>	<u>2715</u>	
Tr. <u>max</u>	<u>2782</u>	<u>2780</u>	
Dg.			
B.L.			
L.			
K.C.		<u>2594</u>	
B.K.C.			
Ce.	<u>2986</u>		
C.			
M.	<u>3132</u>	<u>3132</u>	
M.			
K.			
Mz.			
Mq.			
V.			
S.			
S.			
A.		<u>3609</u>	
R.			
Pf.			
G.			
T.D.	<u>3609</u>		

Loc. in Sec. NE NE NW
 Geol. Glen
 Contr. Smitherman
 Pool Posey



Date Comm. 5-7-58 (Sun - DHC)
 Location MAY 7 '58 MAY 14 '58 8" 207

erd 2430-47 rec full cd 2717-
42 rec full MAY 21 '58 DST 3133-41
op 60" 300 gip 60' OCM BHP 544/30
 in log

D&A