


Cowley

KANSAS

SECTION 28 TOWNSHIP 33S RANGE 4E

WELL NO. #1 French

COMPANY A. D. Allison, etal

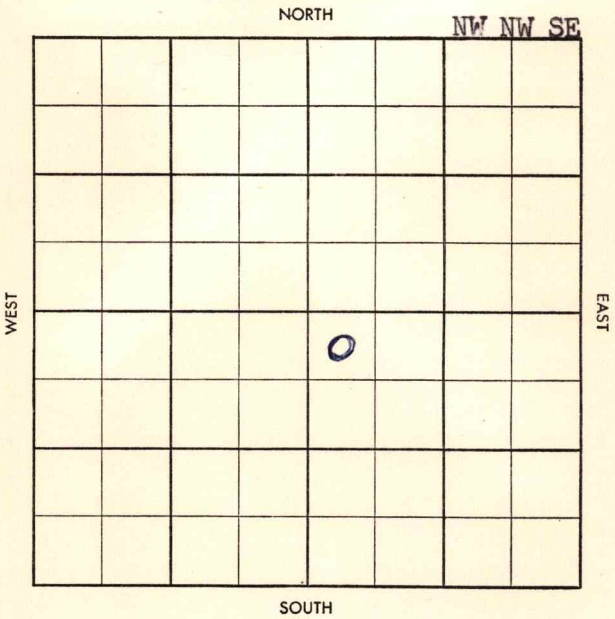

~~Twp~~ ~~Pool~~

~~Co.~~ ~~Facet~~

5-513-B

County Cowley Elev. _____
 Sec. 28 Twp. 33 Rge. 4E
 Company A. D. Allison Etal
 Farm Name French No. 1

TOPS	DEPTH	LOG	DATUM
Anh. <u>10tan</u>	<u>1005</u>		
Tp. <u>STOI</u>	<u>2025</u>		
H. <u>Log</u>	<u>2460</u>		
Tr.			
Dg.			
B. L.			
L.			
K.C.	<u>2618</u>		
B.K.C. <u>cler</u>	<u>2770-74</u>		
Ce.			
C.			
M. <u>Ch. +</u>	<u>3174</u>		
M.			
K.			
Mz.			
Mq.			
V.			
S.			
S.			
A.			
R.			
Pf.			
G.			
T.D.	<u>3190</u>		

Loc. in Sec. NW NW SE

Geol. _____
 Contr. G. D.
Smitherman

Pool Posey

ABANDONED
 1/1
 JUN 11 '58

Date Comm. _____

Location MAY 24 '58 JUN 3 '58 JUN 11 '58 AS DSE

3178-90 1hr 10' HM spts oil
30' M spts oil 30' MW FP 15-30
BHP 615/30" no log

DATA

S-513-B

County Cowley Elev. _____
 Sec. 28 Twp. 33 Rge. 4E
 Company A. D. Allison Etal
 Farm Name French No. 1

TOPS	DEPTH	LOG	DATUM
Anh.			
Tp.			
H.			
Tr.			
Dg.			
B.L.			
L.			
K.C.			
B.K.C.			
Ce.			
C.			
M.			
M.			
K.			
Mz.			
Mq.			
V.			
S.			
S.			
A.			
R.			
Pf.			
G.			
T.D.			

Loc. in Sec. _____

NW NW SE

Geol. _____

Contr. G. D.Smitherman

Pool _____

Posey

Date Comm. _____

Location

Co.

Lse.

No.

Sec.

T.

R.