

Cowley

Section 29 Township 33 Range 6-EWell No. #1 BanksCompany Zephyr & Northern Ord.

NORTH

						0	

SOUTH

WEST

EAST

KANSAS


Cowley

Sec. 29 Twp. 33 R. 6-E

Well No. #1 Banks Farm

Zephyr & Northern Ord. Company

NORTH

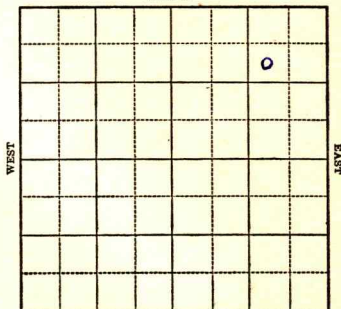

SOUTH

990 Ft. from N. Line

 Ft. from S. Line

990 Ft. from E. Line

 Ft. from W. Line

1943

R E P O R T

10/6 Rotary

10/13 "

10/20 "

10/27 "

11/3 "

11/10 "

11/17 Surface hole

12-1 Miss 3087

TD 3097

Water

ABANDONED

Cowley

KANSAS

Map No. 2 Sec. 29 Twp. 33 R. 6EWell No. 1 BanksZephyr & Northern Ord. Company

FIRST REPORT

Contractor

SW NE NE

SECTION PLAT

990 Ft. from N. Line Ft. from S. Line990 Ft. from E. Line Ft. from W. Line

			0

Miscellaneous

Location Rig up

Drilling and Remarks:

Rotary

RECORD

Cased in., ft.Sand Gas Oil Total Depth

PRODUCTION

1st 24 hrs. Nat. 1st 24 hrs. after shot Gas Cu. Ft.Dry Hole Abandoned

Date

OCT 6 1943 19S. J. LEWIS Scout

Map No. 2 Sec. 29 Twp. 33 R. 6E

Well No. 1 Banks

Zephyr & Northern Ordinance Company

ABANDONED

Contractor

SW NE NE

SECTION PLAT

			a

990 Ft. from N. Line

Ft. from S. Line

990 Ft. from E. Line

Ft. from W. Line

Miscellaneous

Location

Rig up

Drilling and Remarks:

Mis 3087
Water

RECORD

Cased _____ in., _____ ft.

Sand _____

Gas _____

Oil _____

Total Depth 3087

PRODUCTION

1st 24 hrs. Nat. _____

1st 24 hrs. after shot _____

Gas _____ Cu. Ft.

Dry Hole _____

Abandoned _____

Date

DEC 1 1943 19

S. J. LEWIS Scout