


Cowley

Map No. Kansas Sec. 20 Twp. 33 R. 3

Well No. 6 Backus Farm

Waite Phillips Company

NORTH

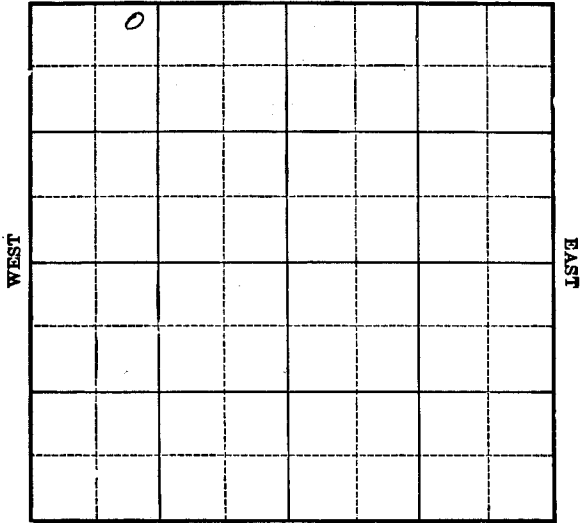

SOUTH

Location \_\_\_\_\_

Drilling Remarks \_\_\_\_\_

Rig Up \_\_\_\_\_

Drilling Remarks \_\_\_\_\_

**RECORD**

Cased \_\_\_\_\_ in. \_\_\_\_\_ ft.

Sand \_\_\_\_\_

Gas \_\_\_\_\_

Oil \_\_\_\_\_

Total Depth \_\_\_\_\_

**PRODUCTION**

1st 24 hrs. Nat. \_\_\_\_\_

1st. 24 hrs. after shot \_\_\_\_\_

Gas \_\_\_\_\_ cu. ft.

Dry Hole \_\_\_\_\_

Abandoned \_\_\_\_\_

Cowley

Map No. Kansas Sec. 20 Twp. 33 R. 3

Well No. 6 Backus Farm

Waite Phillips Company


NORTH

330 Ft. from N. Line

\_\_\_\_\_ Ft. from S. Line

\_\_\_\_\_ Ft. from E. Line

990 Ft. from W. Line

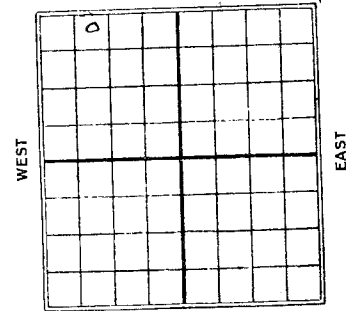

SOUTH

Renear

REPORT

Date 1925

3/1 Location \_\_\_\_\_

6/3 Dly 3110

6/30 Sp. 3254-65 shale 326561

10 bbls

Map No. 1 **KANSAS** Sec. 20 <sup>Cowley</sup> Twp. 33 R. 3

Well No. 6 Backus Farm  
Waite P. Phillips Company

330 x 990' N


FIRST REPORT

S

Location ✓✓  
Rig up  
Drilling and Remarks

RECORD  
Cased ..... in. .... ft.  
Sand .....  
Gas .....  
Oil .....  
Total Depth .....  
PRODUCTION

1st 24 hrs. Nat. ....  
1st 24 hrs. after Shot ...  
Gas ..... cu. ft.  
Dry Hole .....  
Abandoned .....

Date 3/1 19 25  
M. A. BENEAR Scout

Form 26-1M Bks.-3-23-11959.

Map No. **KANSAS** Sec. 20 Twp. 33 R. 3E

Well No. 6 Backus  
Waite P. Phillips Company

Contractor

COMPLETED SECTION PLAT

330 Ft. from N. Line  
..... Ft. from S. Line  
..... Ft. from E. Line  
990 Ft. from W. Line


Location .....  
Rig up .....  
Drilling and Remarks:

sand 3254-3266  
shole 3265-66  
Chat 3266-76-77  
30/10 H<sub>2</sub>O

RECORD  
Cased ..... in., ..... ft.  
Sand .....  
Gas .....  
Oil .....  
Total Depth .....

PRODUCTION  
1st 24 hrs. Nat. ....  
1st 24 hrs. after shot .....  
Gas ..... Cu. Ft.  
Dry Hole .....  
Abandoned .....

Date  
JUN 30 1925 M. A. BENEAR Scout