


Cowley **KANSAS**

SECTION 20 TOWNSHIP 33 RANGE 3E

WELL NO. #10 W. Rainbow Bend Unit

COMPANY Sunray Mid-Continent Oil

NORTH SW NW NW

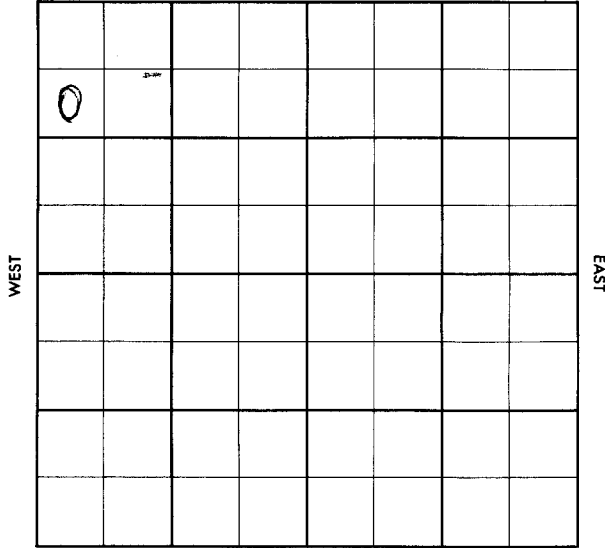

SOUTH

HOT FILE Cowley **KANSAS**

SEC. 20 TWP. 33 S R. 3 E

WELL NO. (Rainbow Bend Wtr # 10 W. Rainbow Bend Unit Flood)

COMPANY Sunray Mid-Continent (DEVELOPMENT)

CONTRACTOR Stickle Drlg. Rainbow Bend Field.

770 FT. FROM N. LINE


FT. FROM S. LINE

FT. FROM E. LINE

200 FT. FROM W. LINE

of Sec.

SW NW NW

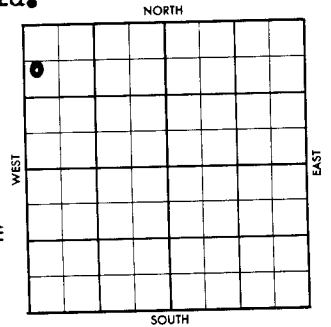

ELEVATION 1168 DF REPORT

DATE	DESCRIPTION	REMARKS
1957	3300' Bartlesville Test	
5/31	Spudded 5-29-57 8-5/8" @ 271/250 TD 273' WOC	(DR#106-1957)
6/3	Drlg. 1990'	
6/4	Drlg. 2455'	(FR Tkt)
6/5	Drlg. 2882'	
6/6	Drlg. 3180'	
6/7	TD 3264'. Prep to run csg.	
6/10	TD 3264'. MICT. 5 1/2" @ 3256'	
6/11	TD 3264'. Drlg. plug.	
6/12	TD 3264' Testing.	
6/13	TD 3264'. Prep to acidize.	
6/14	TD 3264'. Instl. Pumping Unit.	
6/17	TD 3264' " "	
6/18	" " "	
6/19	" " "	
6/20	TD 3264' " "	
6/21	TD 3264' " "	
6/24	" " "	
6/25	TD 3264' " "	
6/26	TD 3264'. Pumping open hole 3256-3264'	
6/27	" " "	
6/28	" " "	

OVER

1957
7/1

TD 3264'. No oil test. Open hole
3256-3264' Bartlesville Zone.
Complete (DR#127)

County Cowley Elev 1168 DF
 Sec. 20 Twp. 33 Rge. 3E
Sunray Mid-Continent Oil
W. Rainbow Bend Unit No. 10

	DEPTH	LOG	DATUM	Loc. in Sec.
Ann.				SW NW NW
TP.				770' fcl x
H.				200' fwl of Sec
Tr.				
Dg.				
BL.				
L.				Geol.
K.C.				Contr.
B.K.C.				Stickle Drl
Ce.	<u>Dart. 3255</u>			Pool
C.				Rainbow Bend
M.	<u>3263</u>			
M.				
K.				
Mz.				
Mo.				
V.				
S.				
S.				
A.				
R.				
PC.				
G.				
TD.	<u>3364 ?</u>			

JUL 10 57
COMPLETE

Date Comm. 5-29-57
 8" @ 271/250, Drlg. 2455 JUN 12 57 Dart
3255 cored 3233-64 rec.
22' sh 7' sat' sd 1 1/2' Lm g
sh 1/2' chert (rec 31)
Miss from core 3263 RTP 3364
5 1/2 @ 3256 MLCR CO JUN 19 57
CO 3264 @ 26 ⁶⁰ below in 5' bed
1/4 @ 1/2 Buph below 4' bed
Post JUN 20 57 X AL 3 57 X JUN 10 57 X
comp 1 Bupd + 1 Bupd w.o. wth Flood

FORM 513 SUNRAY

County Cowley Elev. 1168 DF
 Sec. 20 Twp. 33 Rge. 3E
 Company Sunray Mid-Continent Oil
 Farm Name W. Rainbow Bend Unit No. 10

TOPS	DEPTH	LOG	DATUM	Loc. in Sec.
Anh.				<u>SW NW NW</u>
Tr.				<u>770' fwl x</u>
Dg.				<u>200' fwl of Sec</u>
Bl.				
L.				Geol.
K.C.				Contr.
B.K.C.				
Ce.				<u>Stickle Drlg</u>
C.				
M.				Pool
M.				<u>Rainbow Bend</u>
K.				
Mz.				
Me.				
V.				
S.				
S.				
A.				
R.				
Pe.				
G.				
T.D.				

JUN 5 '57
 FIRST REPORT

Date Comm. 5-29-57
8" @ 271/250, Drlg. 2455

29

Co.
 Sec.
 T.
 R.