


Cowley

KANSASSECTION 20 TOWNSHIP 33 RANGE 3EWELL NO. #11 W. Rainbow Bend UnitCOMPANY Sunray Mid-Continent Oil Co.

NORTH

NW SW NW

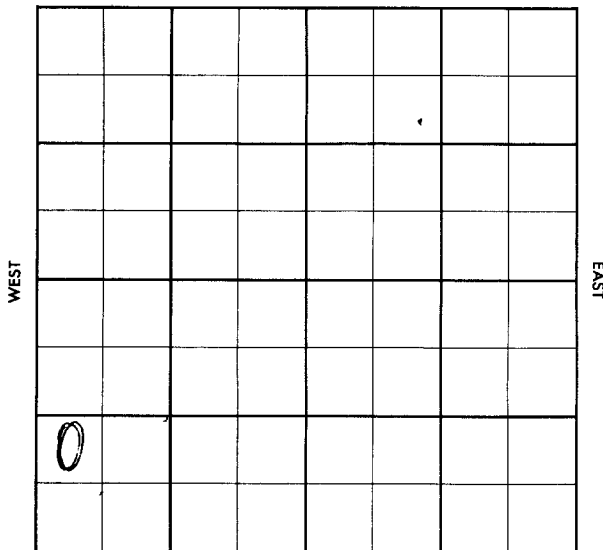

SOUTH

HOT FILE

Cowley

KANSAS
 SEC. 20 TWP. 33 S R. 3 E
 WELL NO. # 11 W. Rainbow Bend Unit (Rainbow Bend WtrFlood FARM)
 COMPANY Sunray Mid-Continent (DEVELOPMENT)

CONTRACTOR


Stickler Drlg.

Rainbow Bend Field.

_____ FT. FROM N. LINE

770 _____ FT. FROM S. LINE

_____ FT. FROM E. LINE

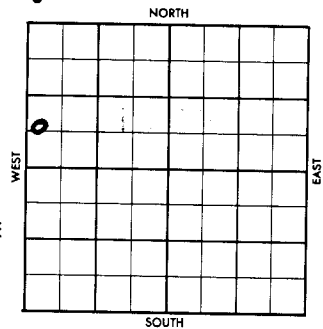300 _____ FT. FROM W. LINEof NW/4
NW SW NW

ELEVATION

REPORT

1957

6/10

 3300' Bartlesville Test
 Spudded 6-8-57 8" @ 250/250 (FR Tkt)
 Drlg. 400' (DR#112)

6/11

Drlg. 995'

6/12

Drlg. 1500'

6/13

Drlg. 2154'

6/14

Drlg. 2540'

6/17

TD 3262'. Prep to run csg.

6/18

TD 3262'. WOC. 5 1/2" @ 3241'

6/19

TD 3262'. WOC. 5 1/2" csg.

6/20

TD 3262' MICT

6/21

TD 3262'. Drlg. plug.

6/24

TD 3262'. Prep to PB

6/25

TD 3262'. Instl. Pumping Unit.

6/26

" " "

6/27

" " "

6/28

" " "

7/1

 TD 3262'. Pumped 35 BO 16 hrs. Open
 hole 3241-3260', Bartlesville Zone
 Complete (DR#127)

FORM 513 SUNRAY

County Cowley Elev. _____
 Sec. 20 Twp. 33 Rge. 3E
 Company Sunray Mid-Continent Oil Co.
 Farm Name W. Rainbow Bend Unit No. 11

TOPS	DEPTH	LOG	DATUM	Loc. in Sec.
Ans.				NW SW NW
Tr.				
Dg.				
BL.				
L.				Geol.
K.C.				Cont.
B.K.C.				Stickle Drlg.
Ce.				Pool
C.				Rainbow Bend
M.				
M.				
K.				
Mz.				
Me.				
V.				
S.				
S.				
A.				
R.				
Pe.				
G.				

FIRST REPORT
 JUN 12 57

Date Comm. 6-10-57
8" @ 250/250, Drlg. 995

89
 JUN 12 1957

Cowley
 20
 Elev. **1159**
 Twp. **33** Rgn. **3E**
 Company **Mid-Continent Oil Co.**
 Farm Name **W. Rainbow Bend Unit** No. **11**

TOPS	DEPTH	LOG	DATUM	Loc in Sec.
Anh.				NW SW NW
Tr.				
Dg.				
Bl.				
L. Barth	3253			
K.C.				Geol.
B.K.C.				Cont.
C.				Stickie Drle
M.				Pool
M.	3261			Rainbow Bend
K.				
Mz.				
Ma.				
V.				
S.				
S.				
A.				
R.				
Pe.				
G.				
T.D.	3262			

JUL 10 '57
COMPLETE

Date Comm. **6-10-57**
 8" @ 250/250, Dril. 995 JUN 10 '57
 Crd 3240-62 Full rec RTP
 3262 Rng 5 1/2" Top
 5 1/2 @ 3241/100 CO 3262
 8 BO + 2 1/2 BW in 8 hrs
 PB 3258 POT P. 69
 BO + 9 BW in 24 hrs
 Barth 3253 Miss # 3261 complete
 69 BO + 9 BW 24 hrs