

KANSAS

Cowley

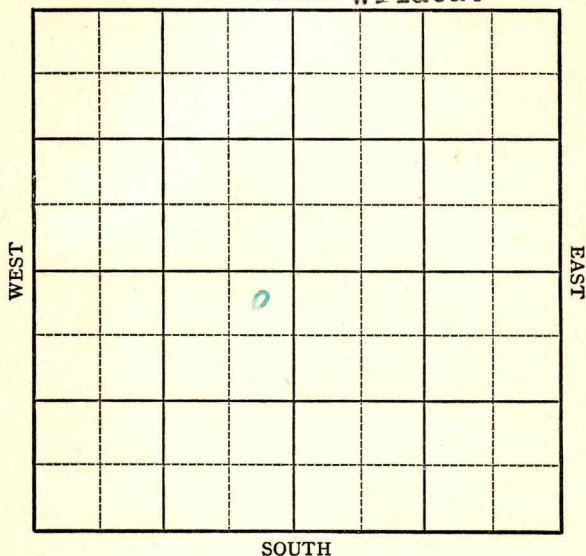
FORM 51 5M 10-41 PETROL

Section 30 Township 33 Range 6-E

Well No. #1 Ford Lorton

Company Texas

NORTH Wildcat



Cowley

KANSAS

Map No. 2 Sec. 30 Twp. 33 R. 6EWell No. 1 Ford

Texas

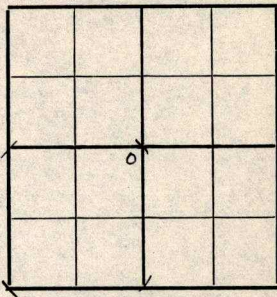
Company

FIRST REPORT

Contractor

NE SW

SECTION PLAT

330 Ft. from N. Line

Ft. from S. Line

330 Ft. from E. Line

Ft. from W. Line

WILDCAT

Location

Rig up

Drilling and Remarks:

Rotary

RECORD

Cased in, ft.

Sand

Gas

Oil

Total Depth

PRODUCTION

1st 24 hrs. Nat.

1st 24 hrs. after shot

Gas Cu. Ft.

Dry Hole

Abandoned

Date

MAR 1 1 1942 19

S. J. LEWIS

Scout

Cowley

KANSAS

Map No. 2 Sec. 30 Twp. 33 R. 6EWell No. 1 Lorton

Texas

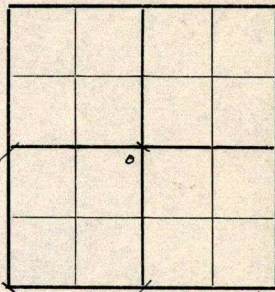
Company

CORRECTION

Contractor

NE SW

SECTION PLAT

330 Ft. from N. Line Ft. from S. Line330 Ft. from E. Line Ft. from W. Line

WILDCAT

Location Rig up

Drilling and Remarks:

Reported

#1 Ford

RECORD

Cased in., ft.Sand Gas Oil Total Depth

PRODUCTION

1st 24 hrs. Nat. 1st 24 hrs. after shot Gas Cu. Ft.Dry Hole Abandoned

Date

MAR 25 1942

19

S. J. LEWIS

Scout

Cowley

KANSAS

Map No. 2 Sec. 30 Twp. 33 R. 6EWell No. 1 Lorton

Texas

Company

ABANDONED

Contractor

NE SW

SECTION PLAT

	o		

330 Ft. from N. Line

Ft. from S. Line

330 Ft. from E. Line

Ft. from W. Line

WILDCAT

Location

Rig up

Drilling and Remarks:

*At 850**No 2 holes*

RECORD

Cased _____ in., _____ ft.

Sand _____

Gas _____

Oil _____

Total Depth 3520

PRODUCTION

1st 24 hrs. Nat. _____

1st 24 hrs. after shot _____

Gas _____ Cu. Ft.

Dry Hole _____

Abandoned _____

Date

APR 8 1942 19S. J. LEWIS Scout