

DX 78-1

Cowley


KANSAS

Section 30 Township 33 Range 6 E

Well No. # 2 Fulton-Green

Company Veeder Supply (Green-Fulton)

NORTH

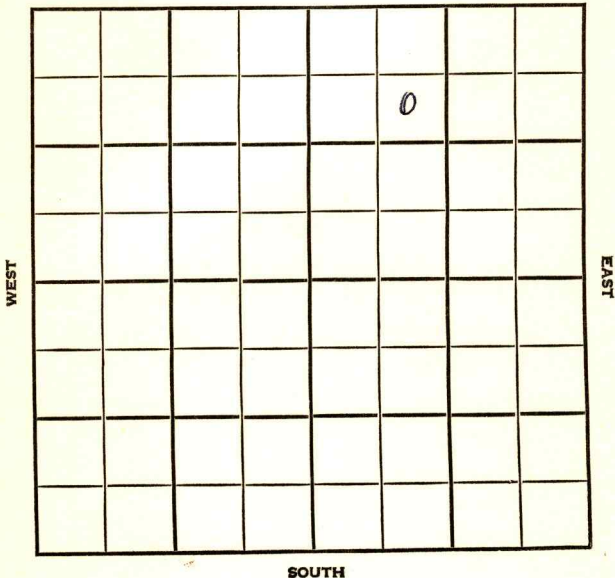

SOUTH

Cowley **KANSAS**

SEC.	TWP.	R.
30	33	6E

WELL NO. **2 Fulton-Green** FARM

COMPANY **Veeder Supply**

CONTRACTOR **Co. Tools**


Wildcat

990 _____ Ft. from N. Line

_____ Ft. from S. Line

_____ Ft. from E. Line

990 _____ Ft. from W. Line

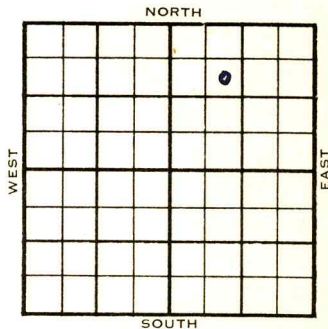

SE NW NE

1954	ELEVATION 1271'	REPORT
------	---------------------------	--------

11/3 Spud 10-20-54
8" @ 70'
D rlg. 1293'

11/10 Spud 10-20-54
D & A
TD 2340'
8" @ 70'
Layton 2258'
DST 2262'-2340' opn 1 hr, rec 360'
msw, 815#
TD 2340'
D & A

ABANDONED

