


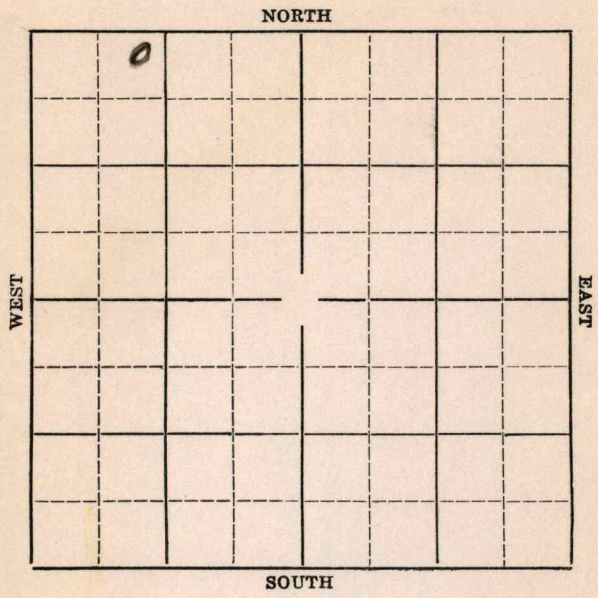

Section 30 Township 33 Range 8-E

Well Number #2 Guthrie

Company Roth & Faurot



Map No. 3 Sec. 30 Twp. 29 R. 8E

Well No. 2. Gutter

Robt & Fawcett Company

Contractor

SECTION PLAT

0			

220 Ft. from N. Line

_____ Ft. from S. Line

_____ Ft. from E. Line

1030 Ft. from W. Line

FIRST REPORT

Location _____

Rig up _____

Drilling and Remarks:

12" @ 360

II-2 19 810

RECORD

Cased _____ in., _____ ft.

Sand _____

Gas _____

Oil _____

Total Depth _____

PRODUCTION

1st 24 hrs. Nat. _____

1st 24 hrs. after shot _____

Gas _____ Cu. Ft.

Dry Hole _____

Abandoned _____

Date

OCT 7 1936 19

S. J. LEWIS Scout

Map No. J 3 Sec. 30 Twp. 33 R. 8E

Well No. 2 Guthrie

Roth & Fawcett Company

Contractor

SECTION PLAT

220 Ft. from N. Line

_____ Ft. from S. Line

_____ Ft. from E. Line

1130 Ft. from W. Line

0			

ABANDONED

Location _____

Rig up _____

Drilling and Remarks:

Miss L 275 4

JFH

RECORD

Cased _____ in., _____ ft.

Sand _____

Gas _____

Oil _____

Total Depth 2805

PRODUCTION

1st 24 hrs. Nat. _____

1st 24 hrs. after shot _____

Gas _____ Cu. Ft.

Dry Hole _____

Abandoned _____

Date

DEC 9 1936

19

S. J. LEWIS

Scout