


Section 31 Township 33 Range 6E

Well No. #1 Berry

Company Crest Pet.

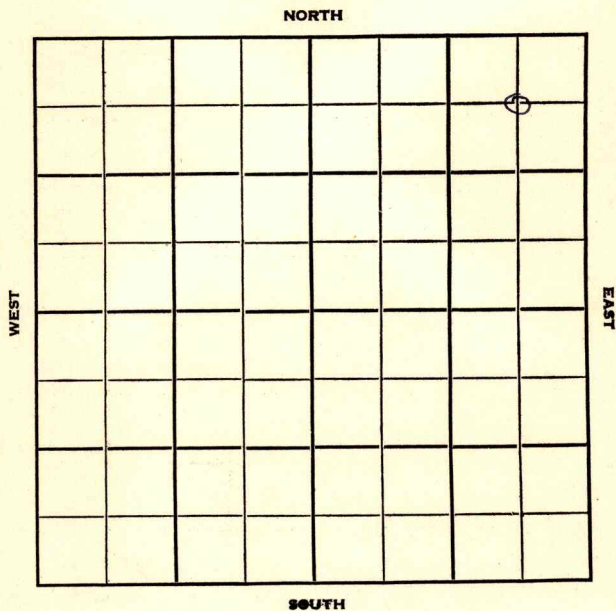

Cowley KANSAS



Sec. 31 Twp. 33 R. 6 E

Well No. # 1 Berry Farm

Crest Pet. Company

Contractor


660 Ft. from N. Line

Ft. from S. Line

660 Ft. from E. Line

Ft. from W. Line

C NE NE

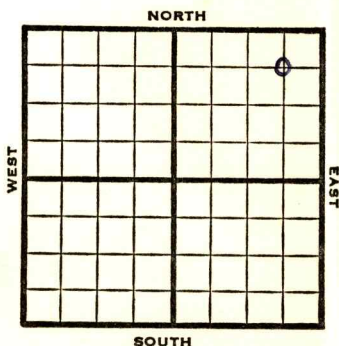

1952

Elev. 1191'

REPORT

5/21

Spud 5-19-52
8" @ 50 WOC


6/25

Spud 5-19-52
Oil Well TD 2197
8" @ 50

Layton 2188

DST 2188-97 opn 1 hr. Rec. 190' oil
30' mud 20' sw TD 2197
5" @ 2188 Comp. 25 bopd

COMPLETED

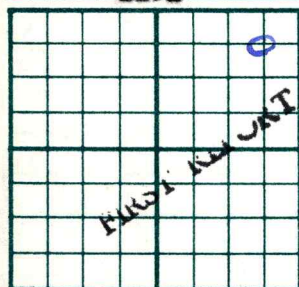County **Cowley** State **Kansas**Sec. **31** (Blk. Twp.) **33** (Sur. Rge.) **6E** Map No.Operator **Crest Pet.**Well No. **1** Farm **Berry**Elev. **1191** Location **C NE NE****660** Ft. From **N** Line **NE****660** Ft. From **E** Line Quarter1st. Report **MAY 21 1952**

Completion

Remarks

Spudding Date **5-19-52**

Drlg. Data

8" @ 50 WOC**J. G. McGEHEE**

County Cowley State Kansas
 Sec. 31 (Blk.) 33 (Sur.) 6 E Map No.

Operator Crest Pet.

Well No. 1 Farm Berry

Elev. 1191 Location C NE NE

COMPLETE

660 Ft. From N Line NE

660 Ft. From E Line Quarter

1st. Report

Completion JUN 25 1952

Remarks

Spudding Date 5-19-52

Drlg. Data Oil well TD 2197

8" @ 50 Layton 2188 DST 2188-97

open 1 hr. Rec. 190' oil 30' mud

20' sw TD 2197 5" @ 2188

Comp. 25 bopd

J. G. McGEHEE