


Section 31 Township 33 Range 6 E

Well No. # 1 Berry

Company Duke & Wood

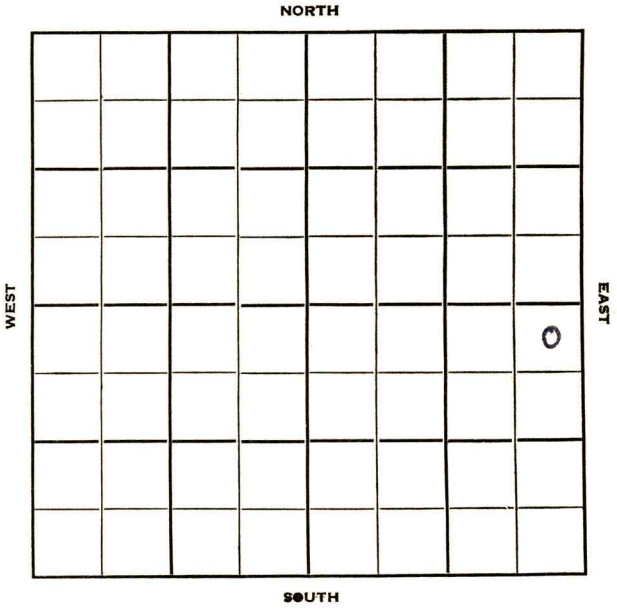

31

33

6 E

Sec. _____ Twp. _____ R. _____

Well No. # 1 Berry Farm _____

Duke & Wood Company _____

Crest Contractor _____

330 Ft. from N. Line


_____ Ft. from S. Line

330 Ft. from E. Line

_____ Ft. from W. Line

NE NE SE

Continental Farmout

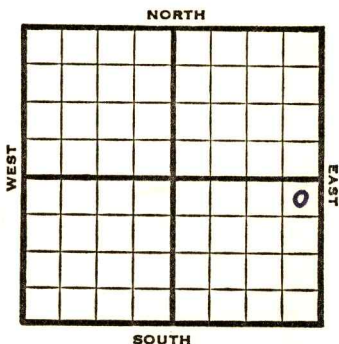

1952 **Elv. -** REPORT

8/13 RU

10/22 Spud 8-14-52
 Oil well TD 2158' 8" @ 71
Layton 2153' TD 2156' 5" @ 2153
 DD 2158 Perf/2152-58 2 BOPH
 P/7 BOPD
 Comp. 10 BOPD

COMPLETED

